

**1999 Alpena County Remonumentation Corner
LAND CORNER RECORDATION CERTIFICATE
Filing Requirement of Act 74, Mich. P.A. 1970**

REMONUMENTATION

JAN 21 2000

For corners in

Alpena
(County)

Located In:

Corner Code #

SECTION 1

1. Public Land Survey

T 29N R5E

M-3

T 29N R6E

A-3 ✓

T _____ R _____

T _____ R _____



L- 2 P- 268

12/10/1999 01:39P

Page: 1 of 1

Kathy J. Matash, Register Alpena Co., MI LDC 9.00

2. Property Controlling in Section

S _____ T _____ R _____

S _____ T _____ R _____

3. Miscellaneous Property in Sec.

S _____ T _____ R _____

S _____ T _____ R _____

Register of Deeds Stamp & File Number

4. Lot No. _____, Recorded Plat _____
5. Private Claims _____

	A	B	C	D	E	F	G	H	I	J	K	L	M
1													
2	6		5		4		3		2		1		
3													
4	7		8		9		10		11		12		
5													
6	18		17		16		15		14		13		
7													
8	19		20		21		22		23		24		
9													
10	30		29		28		27		26		25		
11													
12	31		32		33		34		35		36		
13													

I, Daniel T. Kibbe, in a field survey on June 14, 1999 do hereby state that under requirements of P.A. 74, Michigan P.A. of 1970, the corner points mentioned in lines 1 and 2 above were in conformance with regulations and rules therefore as required in the current manual of survey instructions of the United States Department of the Interior, Bureau of Land Management or by a decree of a Court of Law and /or that the corner points mentioned in lines 3, 4 and 5 above were in conformance with the rules of the Michigan Board of Land Surveyors or by a Decree of a Court of Law; established, re-established, monumented, recovered, found as expressed below:

NOTE: Not more than 2 corners, all in the same town and range, may be recorded on this certificate

A. Description of original monument and accessories and/or subsequent restoration:

- 1839: GLO Survey by Lewis Clason. Set post. Referenced: W. Pine 6-S53W-04/Y. Pine 10-N11W-37.
- 1889: County Survey by Wm. H. LeRoy. Found point of old stake. Both witnesses were burned down. Set White pine stake 4' sq. & 6' long.
- 1908: County Survey by Jos. W. McNeil. Found point of old stake set by Wm. LeRoy in 1889 from OBT's which are burned out now. Set new stake.
- 1959: MDOT Survey by N.C. Caldwell. 3/4" Pipe. Referenced: "x" in ring-S45E-92.04'/P. Pole-S70W-92.04'/Guy Pole-N69E-70.21'
- 1959: MDOT Survey by N.C. Caldwell. Found 1 1/4" pipe 6.13' right Sta 386+20.30. Referenced: 18" N. Pine-N44E-128.80'/SW Corner Stone house-N60E-133.35'/SE Corner School-N29W-215.08'
- 1962: MDOT Recorded corner by Gerald Wozniack. Found 1 1/4" pipe in mon box 6.13' right C/L M-65. Referenced: Guy pole-N69E-70.21'/P.Pole-S70W-92.04'/Chis. "x" in culvert ring-S45E-36.25'.
- 1962: Witness records by Porter survey. Found 1 1/4" pipe in mon box 6.13' right C/L M-65. (Gerald Wozniack) Referenced: Guy pole-N69E-70.21'/P.Pole-S70W-92.04'/Chis. "x" in culvert ring-S45E-36.25'.
- 1990: Survey by Duane R. MacNeill. Referenced corner.
- 1990: Survey by Earl T. Lewis. Existing mon. box. Referenced: Power Pole-S45W-83'/Tel. Pole-N45W-122'. Survey Witnesses by Gary St. Charles. 1" pipe in mon box-M-65 Hwy. Referenced: Tel. Pole-N63E-70.02'/Tel. Ser. Pole-N51W-121.92'/Power Pole-S72W-82.76'.
- 1993: MDOT Recorded Corner by Clifford C. Lindgren. Set 1/2" re-rod in mon box after construction 7' East M-65 C/L at Beaver Lake Park Road West. Referenced: Fd. MSHD tag in P.Pole-N68E-70.07'/Fd nail in P.Pole-N20W-156.04'/N/Tag T. Service Pole-N45W-121.88'/Found nail in P.Pole-S65W-82.82'
- 1993: Recorded Corner by Clifford C. Lindgren. Found 1 1/4" pipe in mon. box 6.13' East of C/L and Beaver Lake Park Road West. Witnessed corner before construction. In 1993 corner was removed during construction. Set 1/2" re-rod in mon box after construction 7' East M-65 C/L at Beaver Lake Park Road West. Referenced: Fd. MSHD tag in P.Pole-N68E-70.07'/Fd nail in P.Pole-N20W-156.04'/N/Tag T. Service Pole-N45W-121.88'/Found nail in P.Pole-S65W-82.82'

B. Description of corner evidence found and/or method applied in restoring or reestablishing corner:

1999: Remon. Survey by Daniel T. Kibbe. Found 1 1/4" pipe in monument box, 6.0' East CL M-65 and on CL Beaver Lake Park Road to West.

This corner position is compatible with county & local surveys. This corner position is accepted as a careful and faithful perpetuation of the position of the original corner.


C. Description of monument for corner and accessories established to perpetuate locating the position of the corner:

1999: Placed 3" Alpena County cap stamped to identify the corner over 1/2" iron rod in 1 1/4" pipe in monument box.

Referenced:

- P. Pole-found tag-S62 W 82.68'
- Telephone Pole-found nail, set tag-N51 W 121.88'
- P.Pole-found MDOT tag-N24 W 155.99'
- P. Pole-w/tele. Riser-found MSHD tag-N65 E 70.06'

Signed by Daniel T. Kibbe
Surveyor's Michigan License No. 37278

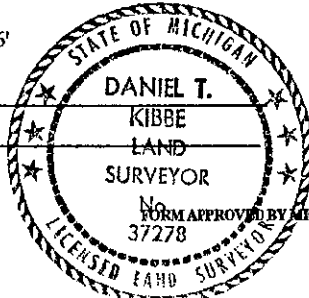

P.A. 345 ALPENa COUNTY
PEER APPROVED 9/16/99

D. J. B. [Signature]

Date November 30, 1999