

MICHIGAN
DEPARTMENT OF CONSERVATION
FORESTRY DIVISION

LAND CORNER RECORD

T. 47 N.R. 34W

Baraga COUNTY


DESCRIPTION OF CORNER Meander Cor. bet. Secs. 20-21 on the south side May Lake.

CORNER MONUMENT 1" pipe with 4" Aluminum cap.

DATE MONUMENT PLACED AND WITNESSED 3/8/66

WITNESSES TO CORNER..... 6" Cedar (M.C. NBT) S15°E, 8.4'

8" Cedar (M.C. NBT) S64°W, 11.8'

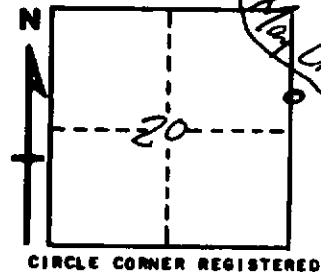

AND

CIRCLE CORNER REGISTERED

DESCRIPTION IN DETAIL AS TO HOW CORNER WAS LOCATED AND IDENTIFIED OR RESTORED.

This corner placed at a blazed cedar on lake shore. Chained south 9.12 chs. to $\frac{1}{4}$ corner.

SURVEYOR'S SEAL

SIGNED Billy O. Buckler DATE 2/8/67
REGISTERED LAND SURVEYOR