

**LAND CORNER RECORDATION CERTIFICATE**  
 Filing Requirement of Act 74, Mich. P.A. 1970 as Amended

For corners in

Baraga <small>(County)</small>	Located In:	Corner Code #
1. Public Land Survey	T _____ R _____	_____
	T _____ R _____	_____
	T _____ R _____	_____
2. Property Controlling in Section	S <u>1</u> T <u>52N</u> R <u>31W</u>	<u>12</u>
	S <u>1</u> T <u>52N</u> R <u>31W</u>	<u>13</u>
	S _____ T _____ R _____	_____
3. Miscellaneous Property in Sec.	S _____ T _____ R _____	_____
	S _____ T _____ R _____	_____
4. Lot No. _____, Recorded Plat _____		
5. Private Claims		

Register of Deeds Stamp & File Number

1	A	B	C	D	E	F	G	H	I	J	K	L	M
2	6		5		4		3		2		1		
3													
4	7		8		9		10		11		12		
5													
6	18		17		16		15		14		13		
8	19		20		21		22		23		24		
9													
10	30		29		28		27		26		25		
11													
12	31		32		33		34		35		36		
13													

I, Stephan J. Szyszkoski, in a field survey on 12 05/09/2011 do hereby state that under requirements of P.A. 74, Michigan P.A. of 1970, the corner points mentioned in lines 1 and 2 above were in conformance with regulations and rules therefore as required in the current manual of survey instructions of the United States Department of the Interior, Bureau of Land Management or by a decree of a Court of Law and /or that the corner points mentioned in lines 3, 4 and 5 above were in conformance with the rules of the Michigan Board of Land Surveyors or by a Decree of a Court of Law; established, re-established, monumented, recovered, found as expressed below:

**NOTE:** Not more than 2 corners, all in the same town and range, may be recorded on this certificate.

**A. Description of original monument and accessories and/or subsequent restoration:**

(12-Sec. 1) South 1/16 corner, Section 1. 1979 - Established by Dennis Destrampe RLS for Lakes Engineering Company, being noted as POB Lot 2 on a survey which created 10 lots within Government Lots 1 & 2, Section 1. The corner was monumented with a 3/4" iron pin and is shown as being 1323.33' north of Quarter corner L3 and 1317.47' west of a 3/4" pin at 1/16 corner #13.

(13-Sec. 1) Southeast 1/16 corner, Section 1. 1979 - Established by Dennis Destrampe RLS for Lakes Engineering Company, being noted as POB Lot 5 on a survey which created 10 lots within Government Lots 1 & 2, Section 1. The position for the corner was monumented with a 3/4" iron pin and is shown as being 1317.47' east of a 3/4" pin at 1/16 corner #12 and 353.50' south of a 3/4" pin at POB Lot 7.

**B. Description of corner evidence found and/or method applied in restoring or reestablishing corner:**

(12-Sec. 1) Found a 3/4" iron pin, in good condition, set flush to the ground surface, 1323.52' north of Quarter corner L3 and 1317.45' west of a 3/4" pin at 1/16 corner #13. Accepted same as a careful and faithful determination of the position of the corner.

(13-Sec. 1) Found a 3/4" iron pin in good condition, projecting 3" above ground, 1317.45' east of a 3/4" pin at 1/16 corner #12, and 353.35' south of a 3/4" pin at the POB of Lot 7. Accepted the monument as a careful and faithful determination of the position of the corner.

**C. Description of monument for corner and accessories established to perpetuate locating the position of the corner:**


(12) Fd. 3/4" iron pin set flush.  
 Set measuring nail with MDNR tag in the side of:  
 11" Hemlock S74W 9.7' mrkd "PC BT"  
 13" Hemlock N10W 24.05' do  
 8" Hemlock S63E 16.8' do  
 11" Cedar S41W 18.95' do  
 Set sq'd Cedar post adjacent.  
 Bearings are magnetic.

(13) Found 3/4" iron pin projecting 3" a.g.  
 Set measuring nail with MDNR tag in the side of:  
 8" Sugar N54E 23.9'  
 7" Sugar S16W 11.5'  
 6" Sugar N88W 17.35'  
 4" Sugar N40W 8.35'  
 Set sq'd Cedar post adjacent.  
 Bearings are magnetic.

Signed by Stephan J. Szyszkoski  
 Surveyor's Michigan License No. 33986

Date 08/10/2011

For the Michigan Department of Natural Resources, Forest Management Division

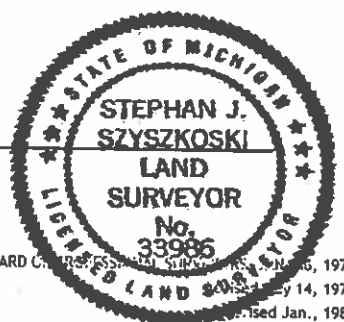

16690  
 16691