

APPROVED LAND CORNER
P.A. 345 OF 1990 - Bay County
Date 19 Sept 96
MTM
Michael MacDonald P.S.
County Representative

Bay County Remonumentation

LAND CORNER RECORDATION CERTIFICATE
Filing Requirement of Act 74, Mich. P.A. 1970

COUNTY OF
REMONUMENTATION
MAY 24 1997
COMMISSION

For corners in

Bay (County)	Located In:	Corner Code #
1. Public Land Survey	T <u>13NR</u> <u>4E</u>	<u>G-6</u>
	T ___ R ___	_____
	T ___ R ___	_____
	T ___ R ___	_____
2. Property Controlling in Section	S ___ T ___ R ___	_____
	S ___ T ___ R ___	_____
3. Miscellaneous Property in Sec.	S ___ T ___ R ___	_____
	S ___ T ___ R ___	_____

RECORDED

Dec 30 4 40 PM '96

Register of Deeds Stamp & File Number

4. Lot No. _____, Recorded Plat _____
5. Private Claims _____

I, Paul M. Ciosek, in a field survey on September 30 96 do hereby state that under requirements of P.A. 74, Michigan P.A. of 1970, the corner points mentioned in lines 1 and 2 above were in conformance with regulations and rules therefore as required in the current manual of survey instructions of the United States Department of the Interior, Bureau of Land Management or by a decree of a Court of Law and/or that the corner points mentioned in lines 3, 4 and 5 above were in conformance with the rules of the Michigan Board of Land Surveyors or by a Decree of a Court of Law; established, re-established, monumented, recovered, found as expressed below:

	A	B	C	D	E	F	G	H	I	J	K	L	M
1													
2	6			5			4		3		2		1
3													
4	7						8		9		10		11
5													
6	18						17		16		15		14
7													
8	19						20		21		22		23
9													
10	30						29		28		27		26
11													
12	31						32		33		34		35
13													

NOTE: Not more than 2 corners, all in the same town and range, may be recorded on this certificate.

A. Description of original monument and accessories and/or subsequent restoration:

G-6 Set post - J. Wampler D.S. in 1822.
Dist to G-5 and G-7 - H. Cary, February 1880 - Sec 15 Surveys.
Fnd 3/4" rod, BTW 2 stones - 14" deep.
B.C.R.C. Witness Card - July 1972.
1/2" pipe in mon box - Spicer Engineering, August 1975.
Mon Box - Recorded Surveys - L. 794, P. 12; L. 805, P. 214; L. 808, P. 442; L. 822, P. 520; L. 861 P. 437.

B. Description of corner evidence found and/or method applied in restoring or reestablishing corner:

G-6 Fnd 1/2" pipe in mon box, 10.5' W of const. centerline Mackinaw Road agrees with B.C.R.C. Witness for 3/4" rod BTW 2 stones 14" deep, July 1972. Spicer Engineering Witness and Recorded Survey Witnesses: Dist G-6 to G-5 = 39.68 ch per H. Cary in 1880 = 2618.88' (2619.2' - R); Dist G-6 to G-7 = 39.76 ch per H. Cary in 1880 = 2624.16' (2622.7 - R). Accepted 1/2" pipe in mon box as best available evidence of the position of the original corner.


C. Description of monument for corner and accessories established to perpetuate locating the position of the corner:

G-6 Set Bay County Remon mon (5/8" x 12" rebar with brass cap marked by 3/16" drill hole) in side of 1/2" pipe in mon box 10.5' W of centerline of Mackinaw Road.

S 55° W 28.07' to conc nail and tag in top centerline of S conc headwall.
N 55° W 27.88' to conc nail and tag in top centerline of N conc headwall.
N 20° W 60.49' to conc nail and tag in top of NW cor of conc box culvert.
NE 69.50' to conc nail and tag in top of SE cor of conc box culvert.
N 70° W 56.07' to nail and tag in N face of P.P.

Signed by Paul M. Ciosek
Surveyor's Michigan License No. 25835

Date 12/23/96

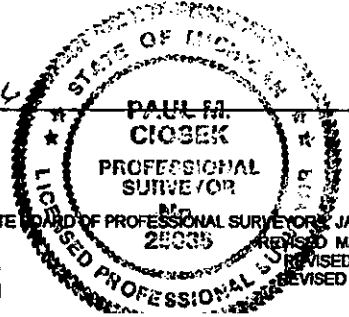

NOTE: Bearings are estimated and dist are hand chained
NOTE: See Bay County Remon Field Book Pg. 17 & 54