



W. 20 W. Lake Twp Berrien Co. SEC. 24

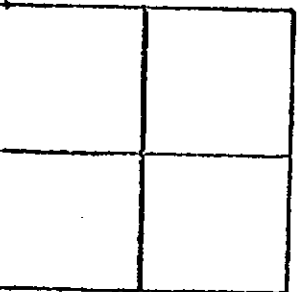


REMARKS

Steel hub

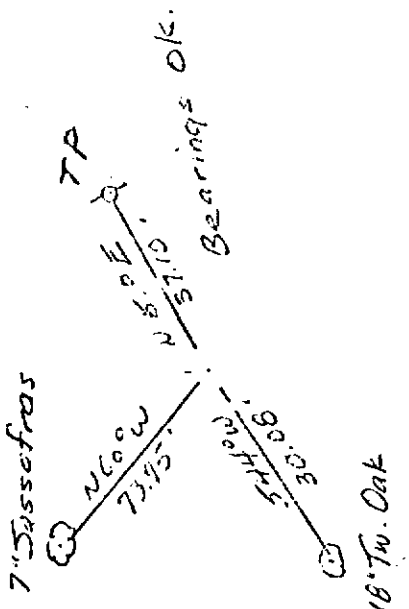

M. 7


T. 6 S. R. 19 W.

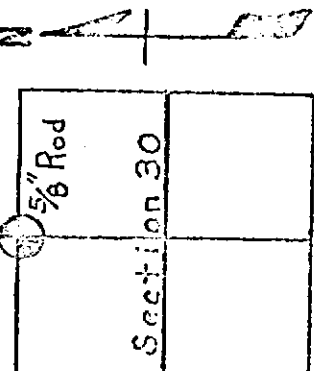

REMARKS

Found 5/8" Iron Rod. 1/4 Cor. fits existing property lines.

D.C.P. - R.L.S. 3165 Dec. 1957

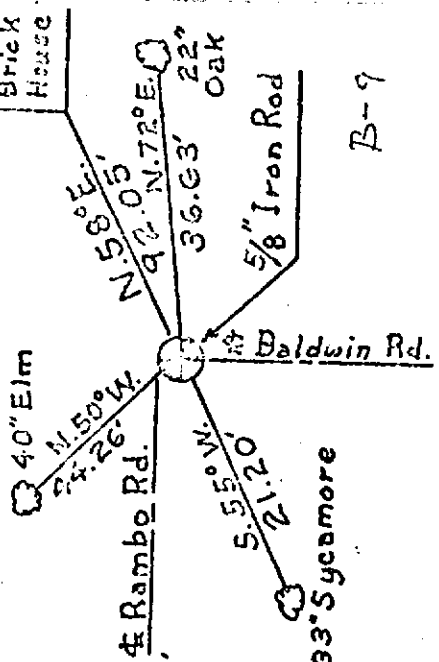


WITNESSES

5" Elm N.50°W, 44.26'  
3" Sycamore S.55°W, 21.20'  
W. Cor. House N.58°E, 36.63'  
2" Oak N.72°E, 36.63'

33' Sycamore

B-9

1/4 Cor. Berrien SEC. 19

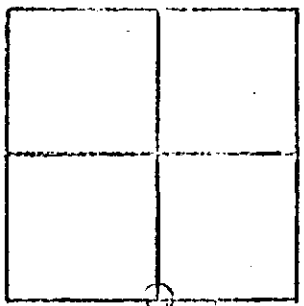

REMARKS

Monument Box in Street Intersection.

T. 6 S. R. 19 W. Lake Twp Berrien Co. SEC. 19

B-7