

SURVEY &
REMONUMENTATION

FEB 06 1999

SECTION

BRANCH COUNTY REMONUMENTATION PROGRAM Number **00003** Page **0264**
LAND CORNER RECORDATION CERTIFICATE
 Filing Requirement of Act 74, Mich. P.A. 1970

For corners in

BRANCH COUNTY Located In: Corner Code #
 ALGANSEE TWP

1. Public Land Survey T 7 S R 5 W K-05
 T _____ R _____
 T _____ R _____
 T _____ R _____

2. Property Controlling S _____ T _____ R _____
 in Section S _____
 T _____ R _____

3. Miscellaneous S _____
 T _____ R _____
 Property in Sec. S _____
 T _____ R _____

STATE OF MICHIGAN
 Branch County
 Recorded

12-07-1998 13:56:08

Linda Lee Morrison-Matheus
 REGISTER OF DEEDS

Register of Deeds Stamp & File Number

ACCEPTED BY THE BRANCH COUNTY
 SURVEY PEER GROUP AS THE OFFICIAL
 CORNER UNDER MICHIGAN PUBLIC ACT 345
 OF 1990 AT A MEETING HELD ON
11-04-98

E.R. Reed, Co. Rep.

E.R. REED

4. Lot No. _____, Recorded Plat _____

5. Private Claims _____

I, EDWARD W. REED, in a field survey on OCTOBER 30, 19 98 do hereby state that under requirements of P.A. 74, Michigan P.A. of 1970, the corner points mentioned in lines 1 and 2 above were in conformance with regulations and rules therefore as required in the current manual of survey instructions of the United States Department of the Interior, Bureau of Land Management or by a decree of a Court of Law and /or that the corner points mentioned in lines 3, 4 and 5 above were in conformance with the rules of the Michigan Board of Land Surveyors or by a Decree of a Court of Law; established, re-established, monumented, recovered, found as expressed below:

NOTE: Not more than 2 corners, all in the same town and range, may be recorded on this certificate.

CORNER COMMON TO SECTIONS 11-12-13-14

A. Description of original monument and accessories and/or subsequent restoration:

- 1825: WM. BROOKFIELD, DEPT SURVEYOR - CORNER SET
- 1876: M. KNOWLES, DEPT SURVEYOR - STONE, BRICK, EARTHEN & GLASS
- 1978: E.R. REED, CO SURVEYOR - FOUND POINTED STONE 16" DEEP SURROUNDED BY BROKEN BRICK & GLASS (GREEN), SET 3/4"X14" IRON PIPE WITH RLS CAP OVER STONE POINT. RECORDED IN LCRC # 00230

B. Description of corner evidence found and/or method applied in restoring or reestablishing corner:

FOUND 3/4" IRON PIPE WITH RLS CAP (REED) FITTING WITNESS OF LCRC # 00230

C. Description of monument for corner and accessories established to perpetuate locating the position of the corner:

SET 1/2" X 18" REBAR IRON WITH REMON CAP OVER STONE IN CI-MONUMENT BOX FLUSH WITH PAVED ROAD SURFACE


- | | | | |
|-----------|----------------------|-----------|----------------------|
| 30" MAPLE | N65E 65.3' TO CENTER | 10" MAPLE | S50W 33.8' TO CENTER |
| 30" MAPLE | N45E 41.7' TO CENTER | 36" MAPLE | S03E 25.8' TO CENTER |
| 42" MAPLE | S60E 61.6' TO CENTER | 30" MAPLE | S35E 37.2' TO CENTER |
| 32" MAPLE | N75E 97.5' TO CENTER | | |

AND IS ACCEPTED AS A CAREFUL AND FAITHFUL PERPETUATION OF THE POSITION OF THE ORIGINAL CORNER.

Signed by *Edward W. Reed*
 EDWARD W. REED

Date NOVEMBER 4, 1998

Surveyor's Michigan License No. 33985

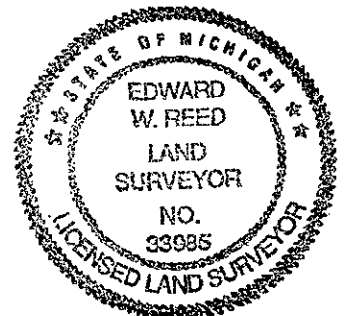

	A	B	C	D	E	F	G	H	I	J	K	L	M
1													
2		6		5		4		3		2		1	
3													
4		7		8		9		10		11		12	
5													
6		18		17		16		15		14		13	
7													
8		19		20		21		22		23		24	
9													
10		30		29		28		27		26		25	
11													
12		31		32		33		34		35		36	
13													