

# SURVEY & REMONUMENTATION

MAR 21 1997

COMMISSION

APPROVED

Date Oct. 16 1996 *DGA*

CALHOUN COUNTY  
REMONUMENTATION.

CALHOUN COUNTY REMONUMENTATION  
LAND CORNER RECORDATION CERTIFICATE  
Filing Requirement of Act 74, Mich. P.A. 1970

STATE OF MICHIGAN  
CALHOUN COUNTY  
RECORDED

18 OCT 96 2:33 P.M.

ANNE B. NORLANDER  
CLERK - REGISTER OF DEEDS

LIBER 1893 PAGE 312

Register of Deeds Stamp & File Number

For corners in

CALHOUN	Located In:	Corner Code #
(County)		
BURLINGTON TOWNSHIP		
1. Public Land Survey	T <u>4</u> S R <u>7</u> W	K-7
	T ___ R ___	_____
	T ___ R ___	_____
	T ___ R ___	_____
2. Property Controlling in Section	S ___ T ___ R ___	_____
	S ___ T ___ R ___	_____
3. Miscellaneous Property in Sec.	S ___ T ___ R ___	_____
	S ___ T ___ R ___	_____

4. Lot No. \_\_\_\_\_, Recorded Plat \_\_\_\_\_  
5. Private Claims \_\_\_\_\_

I, MICHAEL A. GROAT, in a field survey on OCTOBER 1, 1996 do hereby state that under requirements of P.A. 74, Michigan P.A. of 1970, the corner points mentioned in lines 1 and 2 above were in conformance with regulations and rules therefore as required in the current manual of survey instructions of the United States Department of the Interior, Bureau of Land Management or by a decree of a Court of Law and /or that the corner points mentioned in lines 3, 4 and 5 above were in conformance with the rules of the Michigan Board of Land Surveyors or by a Decree of a Court of Law, established, re-established, monumented, recovered, found as expressed below.

**NOTE:** Not more than 2 corners, all in the same town and range, may be recorded on this certificate.

	A	B	C	D	E	F	G	H	I	J	K	L	M
1													
2	6	5	4	3	2	1							
3													
4	7	8	9	10	11	12							
5													
6	18	17	16	15	14	13							
7													
8	19	20	21	22	23	24							
9													
10	30	29	28	27	26	25							
11													
12	31	32	33	34	35	36							
13													

A. Description of original monument and accessories and/or subsequent restoration:

1825, ORIGINAL SURVEY BY DEPUTY SURVEYOR CLARK, SET POST, WHITE OAK, 8", N 65° E, 16 LINKS, YELLOW OAK, 10", N 58° W, 20 LINKS

A.H. CHASE, C.E. #677, IN 1910, NOTED BRICK AND STONE, WITNESSED TO A 30" B. OAK, SW, 68 FEET AND A 18" ELM, SE, 43.5 FEET

B. Description of corner evidence found and/or method applied in restoring or reestablishing corner:

FOUND PIPE IN A MONUMENT BOX IN THE CENTERLINE OF ROADS. EXCAVATED AND FOUND BRICK AND BROKEN POTTERY. ACCEPTED THE POSITION OF THE PIPE AS A FAITHFUL PERPETUATION OF THE ORIGINAL CORNER AS NOTED BY CHASE.


C. Description of monument for corner and accessories established to perpetuate locating the position of the corner:

SET A BERNTSEN MONUMENT IN A MONUMENT BOX AND STAMPED P.S. #39079 AND SECTION INFORMATION IN THE BRASS CAP.

WITNESSES:

NAIL AND SPOTTER IN A 12" CHERRY, 353° NAZ, 115. ET  
NAIL AND SPOTTER IN A 12" WALNUT, 20° NAZ, 148.3 FEET  
NAIL AND SPOTTER IN A 8" LOCUST, 110° NAZ, 122.1 FEET  
STOP SIGN POST, 80° NAZ, 80.7 FEET

NAZ = AZIMUTH MEASURED FROM MAGNETIC NORTH

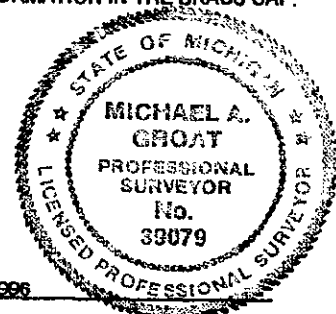

Signed by Michael A. Groat  
Surveyor's Michigan License No. 39079

Date OCTOBER 16, 1996