

**SURVEY &  
REMONUMENTATION**

**JAN 23 2001**

**LAND CORNER RECORDATION CERTIFICATE**

Filing Requirement of Act 74, Mich. PA 1970

CLARE COUNTY REMONUMENTATION

**SECTION**

|   |   |                      |      |               |
|---|---|----------------------|------|---------------|
| For Corners In:<br>Clare<br>(County)    |   | Located In           |      | Corner Code # |
| 1. Public Land Survey                   | T | 17N                  | R 5W | F10           |
|   | T |                      | R    |               |
| 2. Property Controlling<br>in Section   | S | T                    | R    |               |
|   | S | T                    | R    |               |
| 3. Miscellaneous<br>Property in Section | S | T                    | R    |               |
|   | S | T                    | R    |               |
| 4. Lot No: _____                        |   | Recorded Plat: _____ |      |               |
| 5. Private Claims: _____                |   |                      |      |               |


200000009718  
Filed for Record in  
CLARE COUNTY MICHIGAN  
CAROL MCAULAY  
On 11-29-2000 At 12:12 PM.  
LAND CORNER 9.00  
OR Liber 2 Page 247 - 247

Instrument Liber Page  
200000009718 OR 2 247  
#452-00

Register of Deeds Stamp & File Number

I, Craig W. McVean, in a field survey on July 27, 2000 do hereby state that under requirements of PA 74, Michigan PA of 1970, the corner points mentioned in lines 1 and 2 above were in conformance with regulations and rules therefore as required in the current manual of survey instructions of the United States Department of the Interior, Bureau of Land Management or by a decree of a Court of Law and/or that the corner points mentioned in lines 3, 4 and 5 above were in conformance with the rules of the Michigan Board of Land Surveyors or by a Decree of a Court of Law; established, re-established, monumented, recovered, found as expressed below:

**NOTE: Not more than 2 corners, all in the same town and range, may be recorded on this certificate.**

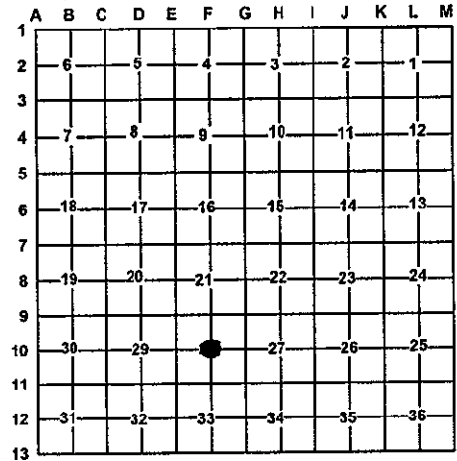

A. Description of original monument and accessories and/or subsequent restoration:  
F10-None

**APPROVED LAND CORNER**  
P.A. 345 of 1990  
Clare County

Chairman Paul S. Lujan  
Date 10-25-00

B. Description of corner evidence found and/or method applies in restoring or re-establishing corner:  
F10-C 1/4, Sec. 28-Set 4" DNR Alum. Cap on 1" x 36" Galv. Iron Pipe in ring of stone at intersection of 1/4 lines in swamp.  
DNR Monument accepted as the best available evidence of the position of the corner.

C. Description of monument for corner and accessories established to perpetuate locating the position of the corner:  
F10- 4" DNR Alum Cap on 1" x 36" Iron Pipe

- Set Blue Carsonite Post 1' SE
- N23°E 37.94' to N & T in W side 14" Cedar scribed 'XBT'
- N58°E 13.71' to N & T in SE side 8" Hemlock scribed 'XBT'
- S50°E 43.65' to N & T in SW side 6" R. Maple scribed 'XBT'
- N87°W 18.82' to N & T in N side 9" Cedar scribed 'XBT'

DNR Mon. used & accepted in place of Clare Co. Remon. Mon.



Signed by: Craig W. McVean  
Surveyor's Michigan License No.: 39088

Date: 10/18/2000