

RECEIVED
 E 10 A 0
 F 54-94
 94 NOV 28 AM 10:37

LAND CORNER RECORDATION CERTIFICATE
 Filing Requirement of Act 74, Mich. P.A. 1970

For corners in

CLARE (County)	Located In:	Corner Code #
1. Public Land Survey	T 20N R 6W	E-7
	T R	
	T R	
	T R	
2. Property Controlling in Section	S T R	
	S T R	
3. Miscellaneous Property in Sec.	S T R	
	S T R	

REGISTER OF DEEDS
 CLARE COUNTY
 DONNA M. CARR

Register of Deeds Stamp & File Number

4. Lot No. _____, Recorded Plat _____
 5. Private Claims _____

I, MARK R. ROBISON, in a field survey on NOVEMBER, 19 94, do hereby certify that under requirements of P.A. 74, Michigan P.A. of 1970, the corner points mentioned in lines 1 and 2 above were in conformance with regulations and rules therefore as required in the current manual of survey instructions of the United States Department of the Interior, Bureau of Land Management or by a decree of a Court of Law and/or that the corner points mentioned in lines 3, 4 and 5 above were in conformance with the rules of the Michigan Board of Land Surveyors or by a Decree of a Court of Law; established, re-established, monumented, re-monumented, recovered, found as expressed below:

	A	B	C	D	E	F	G	H	I	J	K	L	M
2	6	5	4	3	2	1							
3													
4	7	8	9	10	11	12							
5													
6	16	17	16	15	14	13							
7													
8	19	20	21	22	23	24							
9													
10	30	29	28	27	26	25							
11													
12	31	32	33	34	35	36							
13													

NOTE: Not more than 4 corners, all in the same town and range, may be recorded on this certificate.

- A. Description of original monument and accessories and/or subsequent restoration:
- 1856 COLEMAN, G.L.O. PG.530 9-21-09 C.S.R. L.4-PG.124
 POST WIT.- (3) CORNER OF CHURCH N42°E 134 LKS.
 (1) BEECH 6" N57°W 23 LKS. (4) PEAR TREE 8" S49°W 79 LKS.
 (2) HEMLOCK 12" S60°E 51 LKS.
 - 9-17-07 C.S.R. L.6-PG.274 JULY 1942 C.S.R. L.2-PG.123
 WIT.- (3) CORNER OF CHURCH N42°E 134 LKS. (6) WALNUT 18" SOUTH 42.65'
 (4) PEAR TREE 8" S49°W 79 LKS. (7) POWER POLE NE 51'
 - 10-5-09 C.S.R. L.6-PG.270 NO RECORDED SURVEYS
 WIT.- (4) ABOVE
 (5) FENCE POST 8" N45°W 70 1/2 LKS.


- 1-30-81 WILCOX, L.C.R.C. #412
- 1" IRON PIPE
- (6) SOUTH 18" WALNUT 42.65'
- (8) N45°W COR. FENCE POST 42.43'
- (9) S03°W POWER POLE 27.39'
- (10) SOUTH FENCE LINE 2' WEST
- (11) N45°E COR. FENCE POST 47.09'

- B. Description of corner evidence found and/or method applied in restoring or reestablishing corner:
- FOUND 1/2"x18" RE-ROD, WITH SURVEYOR'S CAP INSIDE 3.4 FEET LONG, HALF-MOON SHAPE PIPE IN ASPHALT PAVEMENT.
 FOUND WITNESSES #6, 8, 9, 10, & 11.

APPROVED LAND CORNER
 P.A. 345 of 1990
 Clare County
 Chairman Paul S. Taylor
 Date Nov 23, 1994

This Corner established in Clare County Remonumentation Program.
 See dossier for detailed report.

- C. Description of monument for corner and accessories established to perpetuate locating the position of the corner:
- SET 5/8" X 36" RE-ROD WITH 3" CLARE COUNTY MONUMENT CAP IN MONUMENT BOX.
 WITNESSES:
 N52°W 49.4' 8" FENCE POST - NAIL & TAG
 SOUTH 42.65' 26" WALNUT - NAIL & TAG (6)
 N45°E 47.35' CORNER FENCE POST - NAIL & TAG (11)
 S65°E 66.08' 6" FENCE POST - NAIL & TAG

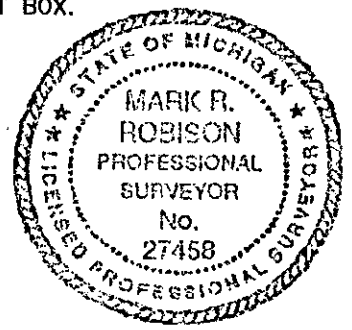

Signed by Mark R. Robison Date 11-23-94
 Surveyor's Michigan License No. 27458