

LAND CORNER RECORDATION CERTIFICATE

Filing Requirement of Act 74, Mich. PA 1970

For Corners In: Crawford (County)	Located In	Corner Code #
1. Public Land Survey	T <u>26</u> R <u>4W</u>	<u>I-4</u>
	T <u>26</u> R <u>4W</u>	<u>H-5</u>
2. Property Controlling in Section	S _____ T _____ R _____	_____
	S _____ T _____ R _____	_____
3. Miscellaneous Property in Section	S _____ T _____ R _____	_____
	S _____ T _____ R _____	_____


Register of Deeds Stamp & File Number

4. Lot No: _____ Recorded Plat: _____

5. Private Claims: _____

I, Carl T. Kiiskila, in a field survey on January 19, 2001 do hereby state that under requirements of PA 74, Michigan PA of 1970, the corner points mentioned in lines 1 and 2 above were in conformance with regulations and rules therefore as required in the current manual of survey instructions of the United States Department of the Interior, Bureau of Land Management or by a decree of a Court of Law and/or that the corner points mentioned in lines 3, 4 and 5 above were in conformance with the rules of the Michigan Board of Land Surveyors or by a Decree of a Court of Law; established, re-established, monumented, recovered, found as expressed below:

NOTE: Not more than 2 corners, all in the same town and range, may be recorded on this certificate.

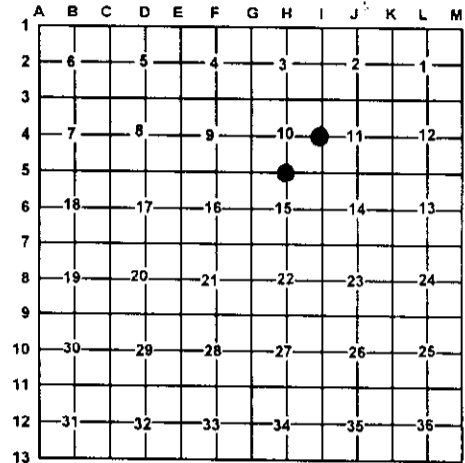

A. Description of original monument and accessories and/or subsequent restoration:

I-4 G.L.O. Addison P. Brewer D.S. 1852
Set quarter section post
Wit: Yellow Pine 16 N65°W 42 links
Yellow Pine 15 S68°E 44 links

H-5 G.L.O. Addison P. Brewer D.S. 1852
Set quarter section post
Wit: White Birch 8 N64°W 12 links
White Birch 10 S36°E 28 links

B. Description of corner evidence found and/or method applies in restoring or re-establishing corner:

I-4 Found 1/2" rod fitting measurements on a working drawing believed to be George D. Henning's R.L.S. #2240.

H-5 Found concrete filled tile with 1/2" rod fitting measurements on a working drawing believed to be George D. Henning's R.L.S. #2240.

C. Description of monument for corner and accessories established to perpetuate locating the position of the corner:

I-4 Set D.N.R. monument
Wit: 9" Jack Pine N71°E 15.43'
5" White Pine South 20.11'
6" Cherry N79°W 61.42'
18" Oak S15°E 38.44'
Carsonite Post North 1±

H-5 Concrete filled tile with 1/2" rod
Wit: *12" Maple N26°W 21.22'
*6" Maple N45°E 16.53'
*14" Red Pine S16°E 48.87'
*10" Maple S29°W 49.39'
Carsonite post North 1±

* old witnesses by others

Signed by: Carl T. Kiiskila
Surveyor's Michigan License No.: 33981

Date: 4-8-02