

SURVEY & REMONUMENTATION

CHEBOYGAN COUNTY REMONUMENTATION CORNER
LAND CORNER RECORDATION CERTIFICATE
 Filing Requirement of Act 74, Mich. P.A. 1970

John
 MAY 03 1995

For corners in
 Cheboygan
 (County)

COMMISSION

Located In:

Corner Code #

- | | | |
|------------------------------------|--------------------------|-------------|
| 1. Public Land Survey | T <u>36N</u> R <u>1W</u> | <u>A-13</u> |
| | T _____ R _____ | _____ |
| | T _____ R _____ | _____ |
| | T _____ R _____ | _____ |
| 2. Property Controlling in Section | S _____ T _____ R _____ | _____ |
| | S _____ T _____ R _____ | _____ |
| 3. Miscellaneous Property in Sec. | S _____ T _____ R _____ | _____ |
| | S _____ T _____ R _____ | _____ |

4. Lot No. _____, Recorded Plat _____
 5. Private Claims _____

DEC 29 1994
 RECEIVED FOR RECORD
 of 12:46 o'Clock P M

James Gray

CLERK/REGISTER
 CHEBOYGAN COUNTY, MICHIGAN

Register of Deeds Stamp & File Number

	A	B	C	D	E	F	G	H	I	J	K	L	M
2	6		5		4		3		2		1		
3													
4	7		8		9		10		11		12		
5													
6	18		17		16		15		14		13		
7													
8	19		20		21		22		23		24		
9													
10	30		29		28		27		26		25		
11													
12	31		32		33		34		35		36		
13													

I, Richard C. Dunn, in a field survey on October, 19 94, do hereby certify that under requirements of P.A. 74, Michigan P.A. of 1970, the corner points mentioned in lines 1 and 2 above were in conformance with regulations and rules therefore as required in the current manual of survey instructions of the United States Department of the Interior, Bureau of Land Management or by a decree of a Court of Law and/or that the corner points mentioned in lines 3, 4 and 5 above were in conformance with the rules of the Michigan Board of Land Surveyors or by a Decree of a Court of Law; established, re-established, monumented, re-monumented, recovered, found as expressed below:

NOTE: Not more than 4 corners, all in the same town and range, may be recorded on this certificate.


A. Description of original monument and accessories and/or subsequent restoration:

G.L.O. John Mullett, 1840
 Set Wood Post
 14" Beech S47°W 20 Links
 8" Beech N32°E 30 Links

Kenneth Ostling #10068, Sept. 3, 1964
 Set 1" pipe w/4" Brass cap by double proportionate measurement as recorded in Liber A, Page 292, Cheboygan County Records.
 7" H. Maple N22°W 30.6'
 9" R. Oak S36°W 53.3'

B. Description of corner evidence found and/or method applied in restoring or reestablishing corner:


A-13 Fnd. 1" Pipe w/4" Brass cap as recorded in Liber A, Page 292, Cheboygan County Records.

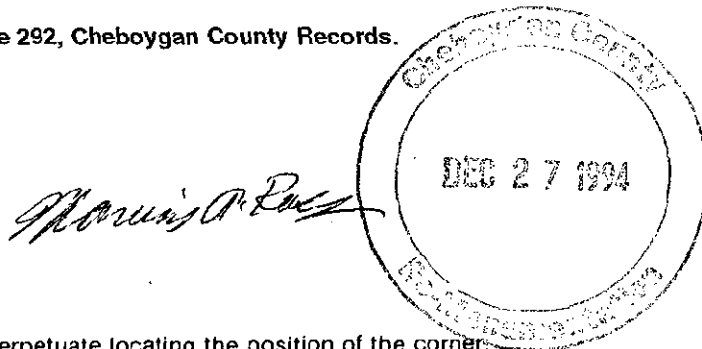

C. Description of monument for corner and accessories established to perpetuate locating the position of the corner:

A-13 Fnd. 1" Pipe w/4" Brass cap as recorded in Liber A, Page 292, Cheboygan County Records and is accepted as a careful and faithful reestablishment of the position of the original corner.
 24" R. Oak S36°W 53.25'
 6" R. Oak S30°E 19.42'
 7" Ash N44°E 16.42'
 15" Maple N22°W 30.67'

LIBER **010** PAGE **94**

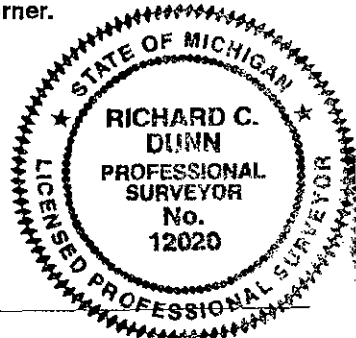

igned by *Richard C. Dunn*

Date December 15, 1994

urveyor's Michigan License No. 12020