

JAN 23 1996

CHEBOYGAN COUNTY REMONUMENTATION
LAND CORNER RECORDATION CERTIFICATE
COMMISSION Filing Requirement of Act 74, Mich. P.A. 1970

For corners in

Cheboygan (County)	Located In:	Corner Code #/
1. Public Land Survey	T 37N R 2W	K-6
	T _____ R _____	_____
	T _____ R _____	_____
	T _____ R _____	_____
2. Property Controlling in Section	S _____ T _____ R _____	_____
	S _____ T _____ R _____	_____
3. Miscellaneous Property in Sec.	S _____ T _____ R _____	_____
	S _____ T _____ R _____	_____

RECEIVED
FOR RECORD
95 DEC 11 PM 4:30

Joanna Spang
CLERK/REGISTER
CHEBOYGAN COUNTY, MICHIGAN

Register of Deeds Stamp & File Number

4. Lot No. _____, Recorded Plat _____
5. Private Claims _____

I, James H. Granger, in a field survey on Aug. 4, 1995, do hereby certify that under requirements of P.A. 74, Michigan P.A. of 1970, the corner points mentioned in lines 1 and 2 above were in conformance with regulations and rules therefore as required in the current manual of survey instructions of the United States Department of the Interior, Bureau of Land Management or by a decree of a Court of Law and/or that the corner points mentioned in lines 3, 4 and 5 above were in conformance with the rules of the Michigan Board of Land Surveyors or by a Decree of a Court of Law; established, re-established, monumented, re-monumented, recovered, found as expressed below:

NOTE: Not more than 4 corners, all in the same town and range, may be recorded on this certificate.

	A	B	C	D	E	F	G	H	I	J	K	L	M
2	6	5	4	3	2	1							
3													
4	7	8	9	10	11	12							
5													
6	18	17	16	15	14	13							
7													
8	19	20	21	22	23	24							
9													
10	30	29	28	27	26	25							
11													
12	31	32	33	34	35	36							
13													

A. Description of original monument and accessories and/or subsequent restoration:

1840 Original Survey Set wood post 24" White Pine S67°W 161ks 10" Hemlock N72°E 41ks
John Mullett


1900 C. Surveyor
1980 Survey Orlando Doyle # 7319 3/4" rod
1988 LCRC James H. Granger # 16041 5/8" rod

B. Description of corner evidence found and/or method applied in restoring or reestablishing corner:

Found 5/8" rod. Set remonumentation cap in monument box

LIBER 010 PAGE 126


Monica A. East

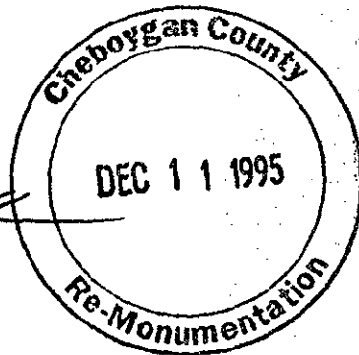

Description of monument for corner and accessories established to perpetuate locating the position of the corner:

5/8" rebar and remonumentation cap in monument box.

Power Pole	N85°W	45.91	Fd nail and washer
5" Pine	N30°W	48.77	Set nail w/tag
Fence post corner	S81°E	27.56	Set nail w/tag
Wood post	N53°E	37.20	Set nail w/tag

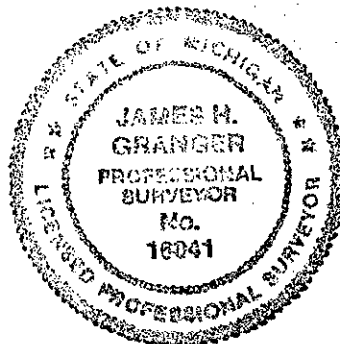

Signed by James H. Granger

Date 10/23/95

Surveyor's Michigan License No. 16041