

SURVEY & REMONUMENTATION

MAR 03 1998

SECTION

LAND CORNER RECORDATION CERTIFICATE

RECORDED

Filing Requirement of Act 74, Mich. P.A. 1970

1997 SEP 10 AM 10:43

For corners in

<u>Dickinson</u> (County)	Located In:	Corner Code #
Sagola Twp.	T <u>41N</u> R <u>30W</u>	<u>A-5</u> & <u>A-6</u>
1. Public Land Survey	T _____ R _____	_____
	T _____ R _____	_____
	T _____ R _____	_____
2. Property Controlling in Section	S _____ T _____ R _____	_____
	S _____ T _____ R _____	_____
3. Miscellaneous Property in Sec.	S _____ T _____ R _____	_____
	S _____ T _____ R _____	_____
4. Lot No. _____, Recorded Plat _____		
5. Private Claims _____		

REGISTER OF DEEDS
DICKINSON COUNTY
RON MOUNTAIN

Register of Deeds Stamp & File Number

I, Edward Kazianka, in a field survey on August 27, 1997, do hereby certify that under requirements of P.A. 74, Michigan P.A. of 1970, the corner points mentioned in lines 1 and 2 above were in conformance with regulations and rules therefore as required in the current manual of survey instructions of the United States Department of the Interior, Bureau of Land Management or by a decree of a Court of Law and/or that the corner points mentioned in lines 3, 4 and 5 above were in conformance with the rules of the Michigan Board of Land Surveyors or by a Decree of a Court of Law; established, re-established, monumented, re-monumented, recovered, found as expressed below:

NOTE: Not more than 4 corners, all in the same town and range, may be recorded on this certificate.

	A	B	C	D	E	F	G	H	I	J	K	L	M
2	6		5		4		3		2		1		
3													
4	7		8		9		10		11		12		
5													
6	18		17		16		15		14		13		
7													
8	19		20		21		22		23		24		
9													
10	30		29		28		27		26		25		
11													
12	31		32		33		34		35		36		
13													

A. Description of original monument and accessories and/or subsequent restoration:

A-5 Wood Post set in 1846 by Austin Burt.
Cedar 14 N16E 36 lks. Cedar 12 S45W 38 lks. Cedar 18 S14 31 Lks.
Dept. of Cons. pipe & cap set in 1954 by Dean DeLaMater.
Cedar 12 S33E 35 lks. Cedar 10 N71E 45 lks. (Both trees are down.)

A-6 Same as above.
Sugar 8 S78W 40 lks. Sugar 12 N50E 29 lks.
2 inch iron pipe recorded in 1983 by Keith Sackett.
Sugar 3 N53W 13.5 ft. Sugar 6 S35W 30.6 ft. Sugar 9 S46E 30.9 ft.

B. Description of corner evidence found and/or method applied in restoring or reestablishing corner:

A-5 Dept. of Cons. pipe & Cap.
A-6 2 Inch iron pipe.


ACCEPTED BY THE DICKINSON COUNTY SURVEY PEER GROUP AS THE OFFICIAL CORNER UNDER MICHIGAN PUBLIC ACT 345 OF 1990 AT A MEETING HELD ON

9-9-97
R. B. [Signature]
COUNTY REPRESENTATIVE

C. Description of monument for corner and accessories established to perpetuate locating the position of the corner:

A-5 Dept. of Cons. pipe & Cap.
Y. Birch 8 N40E 34.70 ft. Y. Birch 6 N75W 15.50 ft.
" 5 S53W 12.05 ft. " 5 S27E 14.20 ft.
3 Inch iron pipe East 21.30 ft.
Carsonite post S45W 3.0 ft.
A-6 Set 3" Dickinson Co Remon. cap on a 5 foot re-rod inside 2" iron pipe.
Sugar 11 N 09E 18.80 ft. Sugar 4 N52W 13.75 ft.
" 8 S35W 30.80 ft. " 11 S45E 31.20 ft.
Carsonite Post S45W 3.0 ft.

Signed by Edward Kazianka Date Sept. 10, 1997
Surveyor's Michigan License No. 14765

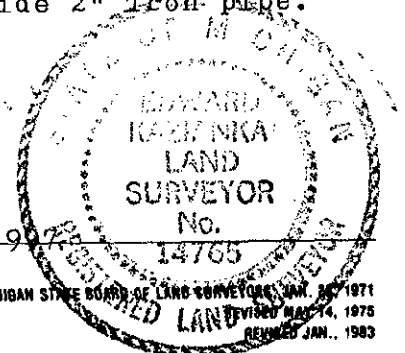

FORM APPROVED BY MICHIGAN STATE BOARD OF LAND SURVEYORS, JAN. 24, 1971
REVISED MAY 14, 1975
REVISED JAN., 1983