

**LAND CORNER RECORDATION CERTIFICATE**  
**Filing Requirement of Act 74, Mich. P.A. 1970**

Register's Office }  
 Gogebic County } SS.

Received for record the  
16<sup>th</sup> day of AUGUST

A. D. 1996 at 2:30 o'clock

P m., and recorded in  
 Liber 6 of CORNERS

on page 36

Richard J. Brown  
 Register of Deeds

Register of Deeds Stamp & File Number

For corners in Gogebic (County)	Located In:	Corner Code #
1. Public Land Survey	Sec. 15 T <u>47N</u> R <u>47W</u>	<u>K-7H</u>
	T _____ R _____	_____
	T _____ R _____	<u>Seg. 2</u>
	T _____ R _____	_____
2. Property Controlling In Section	S _____ T _____ R _____	_____
	S _____ T _____ R _____	_____
3. Miscellaneous Property in Section	S _____ T _____ R _____	_____
	S _____ T _____ R _____	_____

4. Lot No. \_\_\_\_\_, Recorded Plat \_\_\_\_\_  
 5. Private Claims \_\_\_\_\_

Section corner common to 13, 14, 23 & 24, T47N, R47W.

I, John R. Garske, in a field survey on August 29, 1996, do hereby certify that under requirements of P.A. 74, Michigan P.A. of 1970, the corner points mentioned in lines 1 and 2 above were in conformance with regulations and rules therefore as required in the current manual of survey instructions of the United States Department of the Interior, Bureau of Land Management or by a decree of a Court of Law and/or that the corner points mentioned in lines 3, 4 and 5 above were in conformance with the rules of the Michigan Board of Professional Surveyors or by a Decree of a Court of Law; established, re-established, monumented, re-monumented, recovered, found as expressed below:

A	B	C	D	E	F	G	H	I	J	K	L
2	6	5	4	3	2	1					
3											
4	7	8	9	10	11	12					
5											
6	10	17	16	15	14	13					
7											
8	19	20	21	22	23	24					
9											
10	30	29	28	27	26	25					
11											
12	31	32	33	34	35	36					
13											

**NOTE: Not more than 4 corners, all in the same town and range, may be recorded on this certificate.**

**A. Description of original monument and accessories and/or subsequent restoration:**

Original survey by William Ives, D.S., in 1848.

Original Bearing Trees:

Spruce - 10" - N26°W - 17 links      Hemlock - 9" - S66°W - 25 links

The corner position was found by Ewart C., RLS 15408, in July of 1977 marked by a 5/8" diameter solid steel drill rod. He recorded the corner in Liber 1 of corners, page 345 and 346.

Accessories: 3" cherry - S60°E - 72.93 feet; 8" Apple - S07°W - 109.96 feet; N.E. Tower Leg - S56°W - 53.19 feet.

Corner recorded by John Garske, 8/19/94, L5, p 89. Set a standard 2 1/2" dia. x 30" long aluminum monument. Ties: 6" cherry - S57°E - 72.93 feet; 4" cherry - N14°E - 119.42 feet; 6" pine - N23°W - 53.87 feet; N.W. Tower Leg - S59°W - 53.19 feet.

**B. Description of corner evidence found and/or method applied in restoring or reestablishing corner:**

The monument I set in 1994 had been destroyed along with two bearing trees, apparently due to road construction by Keweenaw Lands into their new log yard. I reset the corner from the remaining corner ties and set a witness corner, 80.00 feet south of the section corner on the section line common to Sections 23 and 24. The corner now falls in the gravel roadway, so I set a subsurface monument consisting of a 5/8" dia. x 30" long iron rod with a stamped 3" aluminum cap approximately 4" below the gravel road surface.

(P.A. 74 research on file)

See sketch on back.

PEER GROUP APPROVED  
Richard R. Deakin 9/12/96  
 COUNTY, MICHIGAN

**C. Description of monument for corner and accessories established to perpetuate locating the position of the corner:**

Reset corner as noted above and established accessories:

6" cherry - S57°E - 72.93 feet


6" S. pine - N23°W - 53.87 feet

N.W. Tower Leg - S89°W - 53.19 feet

Witness corner, consisting of a 2 1/2" x 30" aluminum monument stamped - N00°-15'-37"W- 80.00 feet with a steel sign rail - south - 0.72 feet

5/8" x 30" iron rod w/RLS plastic cap (property corner) N01°-06'-32"E on section line - 33.01 feet

Signed by John R. Garske  
 Surveyor's Michigan License No. 28410

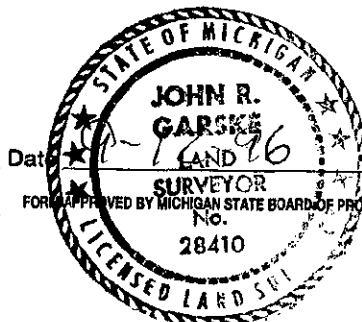

FOR APPROVAL BY MICHIGAN STATE BOARD OF PROFESSIONAL SURVEYORS, JAN. 28, 1971  
 REVISED MAY 14, 1975  
 REVISED JAN., 1983