

MAR 02 2000

SECTION

LAND CORNER RECORDATION CERTIFICATE
Filing Requirement of Act 74, Mich. P.A. 1970

Register's office }
Gogebic County } ss.

For corners in

Gogebic
(County)

Located in:

Corner Code #

- 1. Public Land Survey T48N R46W K-9
- T _____ _____
- T _____ _____
- T _____ _____
- T _____ _____
- 2. Property Controlling S _____ _____
- in Section S _____ _____
- 3. Miscellaneous S _____ _____
- Property in Sec. S _____ _____

Received for record the
21ST day of JULY
A. D. 1999 at 1:25 o'clock
P m., and recorded in
Liber 7 of CORNERS
on page 211
Ramona Collins, Deput
Register of Deeds

Register of Deeds Stamp & File Number

- 4. Lot No. _____, Recorded Plat _____
- 5. Private Claims _____

Section Corner, Sections 23, 24, 25 & 26, T48N, R46W

I, John P. Goss, in a field survey on June 18 19 99 do hereby state that under requirements of P.A. 74, Michigan P.A. of 1970, the corner points mentioned in lines 1 and 2 above were in conformance with regulations and rules therefore as required in the current manual of survey instructions of the United States Department of the Interior, Bureau of Land Management or by a decree of a Court of Law and /or that the corner points mentioned in lines 3, 4 and 5 above were in conformance with the rules of the Michigan Board of Land Surveyors or by a Decree of a Court of Law; established, re-established, monumented, recovered, found as expressed below:

NOTE: Not more than 2 corners, all in the same town and range, may be recorded on this certificate.

	A	B	C	D	E	F	G	H	I	J	K	L	M
1													
2	6		5		4		3		2		1		
3													
4	7		8		9		10		11		12		
5													
6	18		17		16		15		14		13		
7													
8	19		20		21		22		23		24		
9													
10	30		29		28		27		26		25		
11													
12	31		32		33		34		35		36		
13													

A. Description of original monument and accessories and/or subsequent restoration:

Corner established By Austin Burt on May 24, 1851.

Original Bearing trees: Sugar 12" S 70° W 22 links (14.52 ft.)
Sugar 12" N 78° E 40 links (26.40 ft.)

On July 12, 1984, Richard L. Drahn, RLS, restored corner position at record bearing and distance from the stump holes of the two original bearing trees He set a 2" by 30" aluminum monument with 3/4" aluminum cap, stamped to indicated the corner position. He established the follows reference objects:
7" Sugar Maple N 49° E 12.73 ft.; 7" Sugar Maple S 11° W 15.15 ft.;
7" Sugar Maple N 83° W 18.31 ft.; 6' steel sign post N 53° W 1.7 feet.

B. Description of corner evidence found and/or method applied in restoring or reestablishing corner:

He recorded said corner in Liber 2 Page 693 of Land Corners for Gogebic Co.

Found Richard L. Drahn monument and accessories.

Act 74 research on file.


PEER GROUP APPROVED
Richard L. Drahn 7/20/99
COUNTY REGISTERED SURVEYOR

C. Description of monument for corner and accessories established to perpetuate locating the position of the corner:

From the found monument I established the following new and existing reference objects:

- 9" Sugar Maple N 49° E 12.68 ft. new nail
- 8" Sugar Maple S 11° W 15.15 ft.
- 10" Sugar Maple N 83° W 18.27 ft. new nail
- 11" Sugar Maple S 60° E 14.08 ft.
- 6' Steel sign post N 53° W 1.7 ft. to face

(All measurement to nail in side of tree)

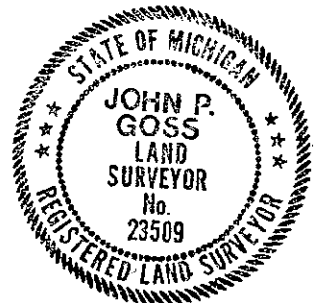

Signed by John P. Goss
Surveyor's Michigan License No. 23509

Date June 18, 1999

U.S.F.S. No. R-21