

SURVEY & REMONUMENTATION

JAN 05 2001

LAND CORNER RECORDATION CERTIFICATE
Filing Requirement of Act 74, Mich. P.A. 1970

SECTION
For corners in

Gogebic Located in: Corner Code #
(County)

1. Public Land Survey T 48N R 45W A-6
T R
T R
T 48N R 46W M-6

2. Property Controlling S T R
in Section S T R

3. Miscellaneous S T R
Property in Sec. S T R

Register's Office }
Gogebic County } ss.

Received for record the
25TH day of August
A. D. 19⁰⁰ at 1:20 o'clock
P m., and recorded in
Liber 8 of COGNES
on page 15
Ramona Collins, Deputy
Register of Deeds

Register of Deeds Stamp & File Number

4. Lot No. _____, Recorded Plat _____
5. Private Claims _____

$\frac{1}{4}$ Corner 18 & 13; T.48 N., R.45²⁰46 W.

I, Richard L. Drahn in a field survey on July 28, 1900 do hereby state that under requirements of P.A. 74, Michigan P.A. of 1970, the corner points mentioned in lines 1 and 2 above were in conformance with regulations and rules therefore as required in the current manual of survey instructions of the United States Department of the Interior, Bureau of Land Management or by a decree of a Court of Law and/or that the corner points mentioned in lines 3, 4 and 5 above were in conformance with the rules of the Michigan Board of Land Surveyors or by a Decree of a Court of Law; established, re-established, monumented, recovered, found as expressed below:

NOTE: Not more than 2 corners, all in the same town and range, may be recorded on this certificate.

	A	B	C	D	E	F	G	H	I	J	K	L	M
1													
2	6	5	4	3	2	1							
3													
4	7	8	9	10	11	12							
5													
6	18	17	16	15	14	13							
7													
8	19	20	21	22	23	24							
9													
10	30	29	28	27	26	25							
11													
12	31	32	33	34	35	36							
13													

A. Description of original monument and accessories and/or subsequent restoration:

Original corner established by John Burt on 9/10/1847. Original B.T.s:
Lynn 18" S.03 W. 25 links (16.50')
Lynn 24" N.45 E. 9 links (5.94')

John F. Meredith, on 4/17/35 recovered two blazed Maples at this corner and placed a location poster on the north side of a 10" Maple. The approximate corner lay N.67 E. 6 ft.

B. Description of corner evidence found and/or method applied in restoring or reestablishing corner:

I restored the corner position at record bearing and distance from the windthrow stump holes of the two original bearing trees. Merediths' tag tree is now a badly decayed 12-14" windthrown Sugar Maple bearing West, 3.5ft. A 1/2" iron pipe set by Gogebic County Forestry Comm. bears S.37 E. 6.93' from the original corner position.


Corner research on file with Gogebic County Records.

C. Description of monument for corner and accessories established to perpetuate locating the position of the corner:

At the corner position I set a 30" long aluminum pipe with a 3 1/4" stamped aluminum cap and the following new bearing trees:

Sugar Maple 12" N.26 W. 20.17'
Sugar Maple 11" S.89 E. 14.76'
Basswood 13" S.27 E. 17.13'
Steel sign rail 6' S.65 W. 2.35'

DEED GROUP APPROVED
Richard L. Drahn 8/23/00
COUNTY DEPARTMENTAL

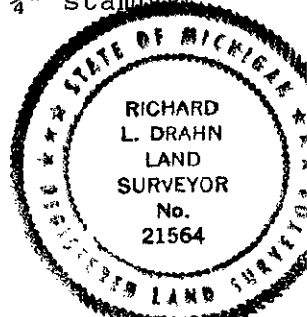

Signed by Richard L. Drahn
Surveyor's Michigan License No. 21564

Date August 17, 2000