

MAR 19 1997

COMMISSION

1996

REMONUMENTATION

Re-Mon Liber 1, Page 51

LAND CORNER RECORDATION CERTIFICATE
Filing Requirement of Act 74, Mich. P.A. 1970

For corners in Sheridan Township

Table with columns: Huron County (County), Located In:, Corner Code #. Rows include Public Land Survey, Property Controlling in Section, and Miscellaneous Property in Sec.

STATE OF MICHIGAN
HURON COUNTY
RECORDED
7 NOV 96 4:07 P.M.
FRANCES L. HOLDWICK
REGISTER OF DEEDS
Register of Deeds Stamp & File Number

4. Lot No. , Recorded Plat
5. Private Claims

I, Russell L. Brown, in a field survey on Oct. 8, 1996 do hereby state that under requirements of P.A. 74, Michigan P.A. of 1970, the corner points mentioned in lines 1 and 2 above were in conformance with regulations and rules therefore as required in the current manual of survey instructions of the United States Department of the Interior, Bureau of Land Management or by a decree of a Court of Law and/or that the corner points mentioned in lines 3, 4 and 5 above were in conformance with the rules of the Michigan Board of Land Surveyors or by a Decree of a Court of Law; established, re-established, monumented, recovered, found as expressed below:

NOTE: Not more than 2 corners, all in the same town and range, may be recorded on this certificate.

Grid table with columns A-M and rows 1-13. Contains numbers 1-36 in a grid pattern.

A. Description of original monument and accessories and/or subsequent restoration:

1834 G.L.O., H. Parke D.S.
Set Post
Beech 15", N53W 28 Links
Hemlock 9", N46W 24 1/2 Links

County Road Commission Records:
Iron Pin
Spike in Power Pole, S40°W 52.70'
Spike in Telephone Pole, S40°E 61.95'

November 12, 1885, County Surveyor Records
Henry Strudwich County Surveyor
Survey of Section 35, T15N-R12E; Corner established at proportionate measurements. No object or accessories stated.

No surveys recorded or unrecorded found.

B. Description of corner evidence found and/or method applied in restoring or reestablishing corner:

Found 3/4" Pipe centerline gravel roads North, South, East and West, 6"+ below surface.


Accepted: Found 3/4" Pipe as the best evidence of the original corner position for corner K-13.

C. Description of monument for corner and accessories established to perpetuate locating the position of the corner:

Corner Sections 35 and 36, T15N-R12E K-13
Found 3/4" Pipe, capped R.L.S. 24588

WITNESSES:

N55°W 35.39' to 1/2" x 18" Steel Stake capped RLS 24588
S45°W 52.80' Found Spike in Southeast Side Power Pole
S55°E 49.49' to North in South End 30" C.M.P.
N55°E 50.83' to Notch in North End 30" C.M.P.

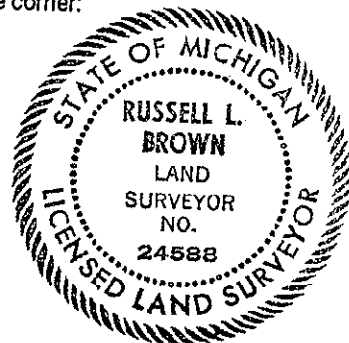

Signed by Russell L. Brown
Surveyor's Michigan License No. 24588

Date 11-05-96

PEER GROUP APPROVED AT MEETING 11-05-96. [Signature]