

**SURVEY &
REMONUMENTATION**

DEC 19 1999

**LAND CORNER RECORDATION CERTIFICATE
Filing Requirement of Act 74, Mich. P.A. 1970**

Liber 9 Page 464

SECTION

For corners in ALAIEDON TOWNSHIP

INGHAM COUNTY	Located In:	Corner Code #
1. Public Land Survey	T 3N R 1W	E-3
	T _____ R _____	_____
	T _____ R _____	_____
	T _____ R _____	_____
2. Property Controlling in Section	S _____ T _____ R _____	_____
	S _____ T _____ R _____	_____
3. Miscellaneous Property in Sec.	S _____ T _____ R _____	_____
	S _____ T _____ R _____	_____

FILED

990033675
07/08/1999 10:33:00
REGISTER OF DEEDS
Paula Johnson
INGHAM COUNTY, MI

Register of Deeds Stamp & File Number

4. Lot No. _____, Recorded Plat _____
5. Private Claims _____

I, Maurice H. Mahieu, in a field survey on May 27, 1999 do hereby state that under requirements of P.A. 74, Michigan P.A. of 1970, the corner points mentioned in lines 1 and 2 above were in conformance with regulations and rules therefore as required in the current manual of survey instructions of the United States Department of the Interior, Bureau of Land Management or by a decree of a Court of Law and /or that the corner points mentioned in lines 3, 4 and 5 above were in conformance with the rules of the Michigan Board of Land Surveyors or by a Decree of a Court of Law; established, re-established, monumented, recovered, found as expressed below:

NOTE: Not more than 2 corners, all in the same town and range, may be recorded on this certificate.

1	A	B	C	D	E	F	G	H	I	J	K	L	M
2		6		5		4		3		2		1	
3					●								
4		7		8		9		10		11		12	
5													
6		18		17		16		15		14		13	
7													
8		19		20		21		22		23		24	
9													
10		30		29		28		27		26		25	
11													
12		31		32		33		34		35		36	
13													

A. Description of original monument and accessories and/or subsequent restoration:

- Original corner set by Musgrove Evans D.S. on December 19, 1826 at a distance of 80.00 chains. "Set post cor Sec's 4, 5, 8, & 9 fw. W. Oak 24 S 23 1/2 E 8. Beech 5 S 83 W 12."
- Corner referred to in subsequent surveys by T. J. Brown D.S. in February, 1848 (V.C. P.13), in November, 1854 (V.C. P. 41), and in January 1856 (V.C. P. 57).
- Ingham County Surveyors Records show surveys by A.P. Drake D.S. in May, 1879 (V.3, P.147) and October 1879 (V.3, P.156) in which corner is described as a post and stones.

(Continued on Back)

B. Description of corner evidence found and/or method applied in restoring or reestablishing corner:


Found a standard concrete monument in a monument box with a non-legible cap ±3' South of centerline Sandhill Road (Bituminous) and on fence lines North and South. Found witnesses: Nail and Tag #25832 East side 12" Oak S 15° E 26.58'. Nail and Tag #18998 North side 40" Oak S 76° W 108.02'. Excavation performed by Surveyor Lester P.S. #18998 as part of County Remonumentation in 1978. Accepted corner as set by Surveyor Lester P.S. #18998 in Liber 4, Page 293 and affixed a 2 1/2" aluminum cap stamped P.A. 345 #28414 over the standard concrete monument.

C. Description of monument for corner and accessories established to perpetuate locating the position of the corner:

Affixed a 2 1/2" diameter aluminum cap stamped P.A. 345 #28414 over a non-legible cap on found standard concrete monument. Witnessed by:
Found Nail and Tag #25832 (Larry Bryan) East side 12" Oak, S 15° E 26.58'
Found Nail and Tag #18998 North side 40" Oak, S 76° W 108.02'
Set Nail and Tag #28414 South side 24" Cedar, N 60° E 132.05'
Chiseled "X" on Top of a 12" C.M.P., S 50° E 36.56'

Signed by Maurice H. Mahieu
Surveyor's Michigan License No. 28414

Date JUNE 16, 1999

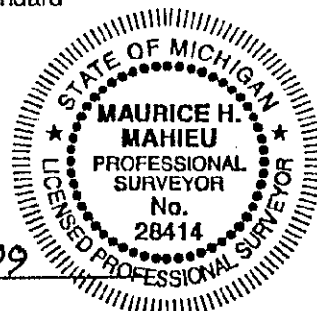

FORM APPROVED BY MICHIGAN STATE BOARD OF PROFESSIONAL SURVEYORS, JAN 28, 1971
REVISED MAY 14, 1975

REVISED JAN, 1983
REVISED OCT, 1995

P.A. 345 INGHAM COUNTY
PEER APPROVED 6/15/99 *ML*

(A. CONTINUED)

- 4. County Surveyor Wm. Barryman described corner as 1 1/8" square iron (plow point and brick); Liber 4, Page 293.
- 5. Ingham County Road Commission Map shows corner to be a 1" iron 2659.92' from F-3 (I.C.R.C. 1962) with the following witnesses: T.P. S 60.86'. 24" Oak Southwest 34.68'. 10" Elm N. 95.74'.
- 6. L.C.R.C. recorded in Liber 4, Page 293 by Ronnie M. Lester P.S. #18998 on August 23, 1978 Accepted 1" x 38" iron stake as corner after massive excavation of area revealed stake was surrounded by large rocks and bits of pottery. Set a 4" x 36" concrete monument with 1/2" x 38" rerod and cap #18998 in location of the 1" x 38" iron stake. Witnesses: Nail and Tag #18998 East side 6" Oak SSE 26.61'. Nail and Tag #18998 North side 14" Oak SW 108.10'. Nail and Tag #18998 East side Wood Post N. 35.23'. Nail and Tag #18998 South side 13" Sycamore NW 260.43'.

SURVEY & REMONUMENTATION

DEC 09 1999

SECTION