

SURVEY & REMONUMENTATION

APR 27 1995

COMMISSION

LAND CORNER RECORDATION CERTIFICATE Filing Requirement of Act 74, Mich. P.A. 1970

For corners in

<u>Iron</u> (County)	Located In:	Corner Code #	
1. Public Land Survey	T <u>43N</u> R <u>34W</u>	<u>L-3</u>	
	T _____ R _____	_____	
	T _____ R _____	_____	
	T _____ R _____	_____	
2. Property Controlling in Section	S _____ T _____ R _____	_____	
	S _____ T _____ R _____	_____	
3. Miscellaneous Property in Sec.	S _____ T _____ R _____	_____	
	S _____ T _____ R _____	_____	
4. Lot No. _____, Recorded Plat _____			
5. Private Claims _____			

REGISTRAR'S OFFICE) ..SS
IRON COUNTY, MICH.)
RECEIVED FOR RECORD THE 21ST DAY OF
FEBRUARY A.D. 19 95 AT
2:45 O'CLOCK P. M. AND RECORDED IN LIBER
6 OF L.C. RECORDS
ON PAGE 377
Mark J. Pisoni
DEPUTY REGISTER OF DEEDS

Register of Deeds Stamp & File Number

Quarter Corner 1, 12, T43N, R34W

I, Gary L. Pisoni, in a field survey on November 1, 19 94 do hereby certify that under requirements of P.A. 74, Michigan P.A. of 1970, the corner points mentioned in lines 1 and 2 above were in conformance with regulations and rules therefore as required in the current manual of survey instructions of the United States Department of the Interior, Bureau of Land Management or by a decree of a Court of Law and/or that the corner points mentioned in lines 3, 4 and 5 above were in conformance with the rules of the Michigan Board of Land Surveyors or by a Decree of a Court of Law; established, re-established, monumented, re-monumented, recovered, found as expressed below:

NOTE: Not more than 4 corners, all in the same town and range, may be recorded on this certificate.

	A	B	C	D	E	F	G	H	I	J	K	L	M
2	6		5		4		3		2		1		
3													
4	7		8		9		10		11		12		
5													
6	13		17		16		15		14		13		
7													
8	19		20		21		22		23		24		
9													
10	30		29		28		27		26		25		
11													
12	31		32		33		34		35		36		
13													

A. Description of original monument and accessories and/or subsequent restoration:

Original corner established by Guy H. Carleton, U.S. Deputy Surveyor in 1851.

Original corner: Wood Post

Original bearing trees:

Maple	10"	S 44°W	50 links (33.00 feet)
Yellow Birch	14"	N 45°E	32 links (21.12 feet)

B. Description of corner evidence found and/or method applied in restoring or reestablishing corner:

No evidence of original corner or bearing tree remains. Local property owner, Chester Karney, indicated to me where the quarter corner used to be located before it was destroyed during logging operations. Corner position checks within reason to GLO distance from the East and West Section corners. Corner position has been used and accepted as the corner locally for many years. Set an aluminum pipe monument 3" above ground surface as described below.

This corner is accepted as the best available evidence of the position of the original corner.

County Record Research on file with County Representative office.

PEER GROUP APPROVED


Iron Gary L. Pisoni

COUNTY REPRESENTATIVE

C. Description of monument for corner and accessories established to perpetuate locating the position of the corner. AD. 11-30-94

At the corner position, I set a 2" diameter by 30" long split base aluminum pipe monument with a 3" cast aluminum cap, stamped to read: Iron County Remonumentation, T43N, R34W, 1/4, S-1, S-12, 1994, RLS- 27457 from which I established the following new blazed and scribed bearing trees: (all measurements taken to a nail in side of tree)

Sugar Maple	8"	N 52°W	29.26 feet
Sugar Maple	9"	N 28°E	28.44 feet
Red Maple	8"	N 76°E	24.24 feet
Cedar	12"	S 13°W	34.85 feet
Steel Sign Post		S 69°E	0.75 feet

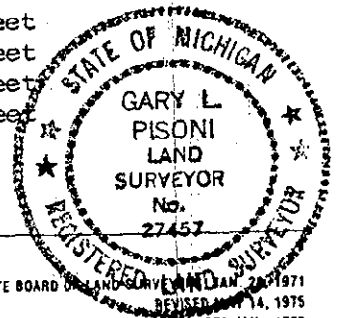

Signed by

Gary L. Pisoni

Date

1-9-95

Surveyor's Michigan License No.

27457

FORM APPROVED BY MICHIGAN STATE BOARD OF LAND SURVEYORS JAN 20 1971
REVISED JAN. 14, 1975
REVISED JAN., 1983

LIBER

6 FACE 377