


TIS, R1E


TIS, R2E

SEG JACKSON CO
MISC #6

12-21-55
Field run
Scott
Miller
O'Connor

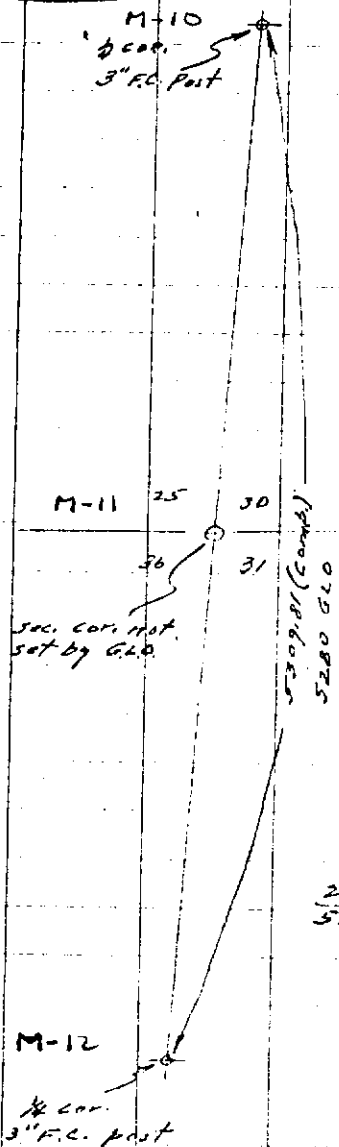

$$\frac{29.8'}{5280} = .00565 \text{ correction}$$

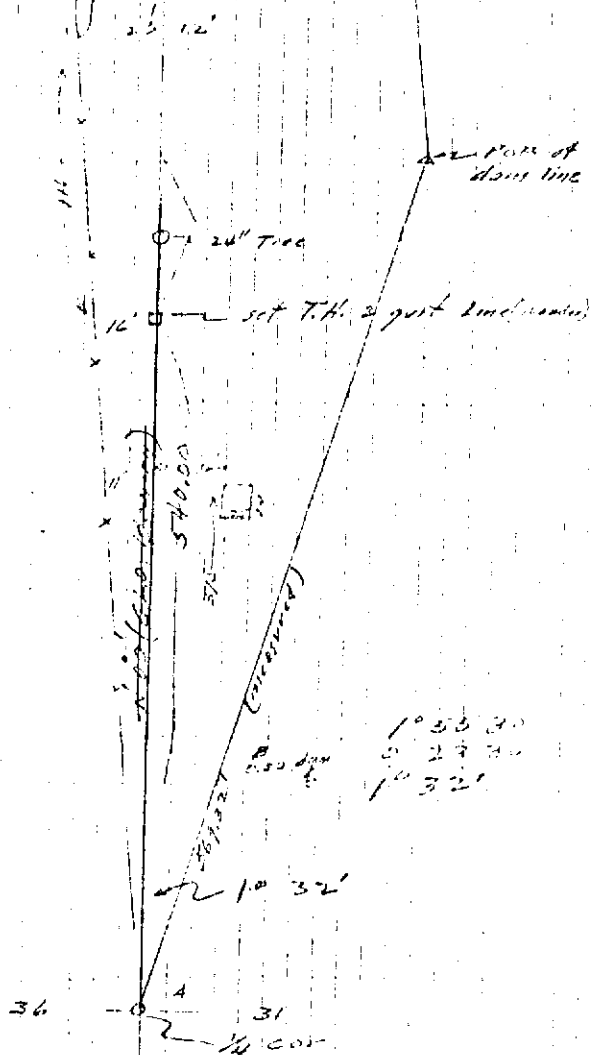

10 35 30
0 27 30
10 32'