

LAND CORNER RECORDATION CERTIFICATE
Filing Requirement of Act 74, Mich. P.A. 1970

For corners in

KALKASKA Located In: Corner Code #
 (County)
 1998 REMONUMENTATION
 1. Public Land Survey T 25N R 8W 1-4
 T ___ R ___
 T ___ R ___
 T ___ R ___
 2. Property Controlling S ___ T ___ R ___
 in Section S ___ T ___ R ___
 3. Miscellaneous S ___ T ___ R ___
 Property in Sec. S ___ T ___ R ___

**SURVEY &
 REMONUMENTATION**

FEB 22 1999

SECTION

Register of Deeds Stamp & File Number

4. Lot No. _____, Recorded Plat _____

5. Private Claims _____

I, EUGENE FARRIER, in a field survey on October 29, 1998 do hereby state that under requirements of P.A. 74, Michigan P.A. of 1970, the corner points mentioned in lines 1 and 2 above were in conformance with regulations and rules therefore as required in the current manual of survey instructions of the United States Department of the Interior, Bureau of Land Management or by a decree of a Court of Law and /or that the corner points mentioned in lines 3, 4 and 5 above were in conformance with the rules of the Michigan Board of Land Surveyors or by a Decree of a Court of Law; established, re-established, monumented, recovered, found as expressed below:

1	A	B	C	D	E	F	G	H	I	J	K	L	M
2		6		5		4		3		2		1	
3													
4		7		8		9		10		11		12	
5													
6		18		17		16		15		14		13	
7													
8		19		20		21		22		23		24	
9													
10		30		29		28		27		26		25	
11													
12		31		32		33		34		35		36	
13													

NOTE: Not more than 2 corners, all in the same town and range, may be recorded on this certificate.

A. Description of original monument and accessories and/or subsequent restoration:

1-4: 1/4 Cor. Common to Secs. 10 & 11, T25N-R8W, Springfield Township
 1852, G.L.O. Sub. resurvey by V.W. Cankin D.S.; set corner; Beech 12", N20°E, 19 Lks. (12.54'); Beech 4", S60°W, 17 Lks. (11.22') Dry Bed of steam, North, 14.42 Ch. (951.72')
 1908, Sec. Sub. Survey by W.S. Merrill CS., FB # 47, Pg. 29, no description for cor. Birch 15", N75°E, 24 Lks. (15.84'); Beech 16", S52°W, 34 Lks. (22.44')
 1909, Sec. Sub. Survey by W.S. Merrill CS., FB # 23, Pg. 158; shows cor. only, no/ acc.
 6-19-89, R. Mitchell, set 1/2" X 18" re-bar w/cap #28417 midway and on line between Sec. corners, LCRC, Liber 2, Pg. 376

Ratified by Peer Group
 P.A. 345 - 1990 Kalkaska County
 Chairman Eugene Farrier
 Date 2-2-99

B. Description of corner evidence found and/or method applied in restoring or reestablishing corner:


1-4: 1/4 Cor. Common to Secs. 10 & 11, T25N-R8W, Springfield Township
 Found and accepted iron & cap #28417 2' East of CL Road (as recorded in LCRC, Liber 2, Pg. 376) Pulled and set 5/8" X 18" re-bar and cap in mon. box.
 N59°E, 31.48' -14" Poplar, found nail
 No G.L.O. witnesses were found.
 Kalkaska County Peer Group accepted the above monument as a careful and faithful reestablishment of the position of the original corner.

C. Description of monument for corner and accessories established to perpetuate locating the position of the corner:

1-4: 1/4 Cor. Common to Secs. 10 & 11, T25N-R8W, Springfield Township
 Found and accepted iron & cap #28417 2' East of CL Road. Pulled and set 5/8" X 18" re-bar and cap in mon. box.
 West, 33.03' - iron & cap #31611
 N59°E, 31.48' -14" Poplar, found nail
 S28°E, 55.84' - 12" Poplar, set nail & washer
 S42°W, 50.10' - 6" W. Pine, set nail & washer
 S05°W, 9.77' - found raised P.K., set nail & washer

Signed by Eugene Farrier
 Michigan License No. 24594

Date 2-8-99

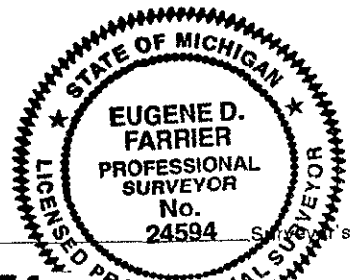

3012674
 Page: 1 of 1

02/10/1999 08:37A

Kalkaska County REMON 9.00 LB: 5 PG: 329

REVISED MAY 14, 1976
 REVISED JAN. 1993
 REVISED OCT., 1995