

LAND CORNER RECORDATION CERTIFICATE
Filing Requirement of Act 74, Mich. P.A. 1970

For corners in

<u>KALKASKA</u>	Located In:	Corner Code #
(County)		
1998 REMONUMENTATION		
1. Public Land Survey	T <u>25N</u> R <u>8W</u>	<u>K-2</u>
	T _____ R _____	_____
	T _____ R _____	_____
	T _____ R _____	_____
2. Property Controlling in Section	S _____ T _____ R _____	_____
	S _____ T _____ R _____	_____
3. Miscellaneous Property in Sec.	S _____ T _____ R _____	_____
	S _____ T _____ R _____	_____

SURVEY & REMONUMENTATION

FEB 22 1999

SECTION

Register of Deeds Stamp & File Number

4. Lot No. _____, Recorded Plat _____

5. Private Claims _____

1	A	B	C	D	E	F	G	H	I	J	K	L
2	6		5		4		3		2		1	
3												
4	7		8		9		10		11		12	
5												
6	18		17		16		15		14		13	
7												
8	19		20		21		22		23		24	
9												
10	30		29		28		27		26		25	
11												
12	31		32		33		34		35		36	
13												

I, EUGENE FARRIER, in a field survey on November 2, 1998 do hereby state that under requirements of P.A. 74, Michigan P.A. of 1970, the corner points mentioned in lines 1 and 2 above were in conformance with regulations and rules therefore as required in the current manual of survey instructions of the United States Department of the Interior, Bureau of Land Management or by a decree of a Court of Law and /or that the corner points mentioned in lines 3, 4 and 5 above were in conformance with the rules of the Michigan Board of Land Surveyors or by a Decree of a Court of Law; established, re-established, monumented, recovered, found as expressed below:

NOTE: Not more than 2 corners, all in the same town and range, may be recorded on this certificate.

A. Description of original monument and accessories and/or subsequent restoration:

K-2: 1/4 Cor. Common to Secs. 1 & 2, T25N-R8W, Springfield Township
 1852, GLO. Sub. resurvey by V.W. Cankin D.S.; Hemlock 24", N80°E, 48 Lks. (31.68'); Beech 5", S50°W, 21 Lks. (13.86')
 1876, Road Survey By D.E. McVean CS., Co. Survey Bk. Pg. 2; measured to fd. cor. no/acc.
 1911, Sec. Sub. Survey by W.S. Merrill CS., FB # 15, Pg. 86, set cedar stake from old witness; shows r.r. grade, East 11.25 Ch. (745.14')
 1913, Sec. Sub. Survey by W.S. Merrill CS., FB # 34, Pg. 8, shows cor. only, r.r. grade East, 10.47 Ch. (691.02')

B. Description of corner evidence found and/or method applied in restoring or reestablishing corner:

K-2: 1/4 Cor. Common to Secs. 1 & 2, T25N-R8W, Springfield Township
 11-2-98, E. Farrier, set 5/8" X 36" re-bar w/alum cap by doubling over Merrill center 1/4 corner thru N 1/8" / SW 1/4" occupation corne falls in centerline of Old North-South road, bed & on fence to West, 30' East to old r/w fence & 24' West of r/w fence, 112' Southeasterly to West line of overhead power.
 No. G.L.O. witnesses were found.
 Kalkaska County Peer Group accepted the above monument as a careful and faithful reestablishment of the position of the original corner


Ratified by Peer Group
 P.A. 345 - 1990 Kalkaska County
 Chairman Eugene Farrier
 Date 2-2-99

C. Description of monument for corner and accessories established to perpetuate locating the position of the corner:

K-2: 1/4 Cor. Common to Secs. 1 & 2, T25N-R8W, Springfield Township
 11-2-98, E. Farrier, set 5/8" X 36" re-bar w/alum cap by doubling over Merrill center 1/4 corner thru N 1/8" / SW 1/4" occupation corne falls in centerline of old North-South roadbed & on fence to West, 30' East to old r/w fence & 24' West of r/w fence, 112' Southeasterly to West line of overhead power.
 N20°E, 22.74' - 4" Cherry, set nail & washer
 S47°E, 32.93' - 4" Cherry, set nail & washer
 S80°W, 42.47' - 8" R. Pine, set nail & washer
 N57°W, 41.42' - 10" R. Pine, set nail & washer

Signed by Eugene Farrier
 Michigan License No. 24594

Date 2-8-99

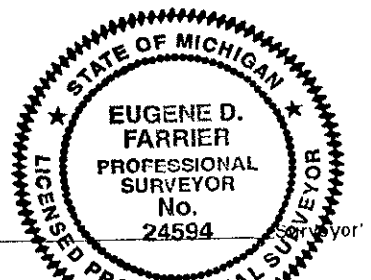

3012678
 Page: 1 of 1
 02/10/1999 08:38A