

FEB 14 1997

KENT COUNTY REMONUMENTATION

COMMISSION

LAND CORNER RECORDATION CERTIFICATE  
Filing Requirement of Act 74, Mich. P.A. 1970

For corners in  
KENT COUNTY

Located In:	Corner Code #
T 6N R 10W	H-8
T R	
T R	
T R	
S T R	
S T R	
S T R	
S T R	

- 1. Public Land Survey
- 2. Property Controlling in Section
- 3. Miscellaneous Property in Sec.

STATE OF MICHIGAN  
COUNTY OF KENT  
RECEIVED FOR RECORD

95 OCT 18 AM 8:19

REG. OF DEEDS

9389

Register of Deeds Stamp & File Number

4. Lot No. \_\_\_\_\_, Recorded Plat \_\_\_\_\_  
5. Private Claims \_\_\_\_\_

I, Kirk Breitels, in a field survey on Sept. 30, 19 96 do hereby state that under requirements of P.A. 74, Michigan P.A. of 1970, the corner points mentioned in lines 1 and 2 above were in conformance with regulations and rules therefore as required in the current manual of survey instructions of the United States Department of the Interior, Bureau of Land Management or by a decree of a Court of Law and /or that the corner points mentioned in lines 3, 4 and 5 above were in conformance with the rules of the Michigan Board of Land Surveyors or by a Decree of a Court of Law, established, re-established, monumented, recovered, found as expressed below:

NOTE: Not more than 2 corners, all in the same town and range, may be recorded on this certificate.

	A	B	C	D	E	F	G	H	I	J	K	L	M
1													
2	6	5	4	3	2	1							
3													
4	7	8	9	10	11	12							
5													
6	18	17	16	15	14	13							
7													
8	19	20	21	22	23	24							
9													
10	30	29	28	27	26	25							
11													
12	31	32	33	34	35	36							
13													

A. Description of original monument and accessories and/or subsequent restoration:

- H-8 1831---GLO---Not Set ---Williams & Works---Set Iron at int. of 1/4 lines
- 1959---Williams & Works---Found Iron: 14" Cher. ENE 18.75' 15" Elm WNW 7.55' 14" Elm SE 28.81'
- 1964---Kent Co. Wit.---Iron: 14" Elm W 7.6' 14" Cherry E 18.9'
- 12" Oak NE 49.1' 12" Maple clump WSW 17.9'
- 1975---LCRC #853---Nederveid---Found Iron
- 14" Cher. E 18.89' 12" Oak NE 49.11' 12" Cl. Maple WSW 17.88'
- 1977---LCRC #1074---Bonnema---Mon.
- 18" Cher. E 19.27' 12" Cl. Maple WSW 17.98' 14" Oak NE 49.54' 10" Oak NW 29.64'
- 1988---LCRC #4908---Bonnema---Set Capped Rerod by holding prev. wit.
- 14" Cherry E 19.28' 14" Oak N 54.60' 14" Oak S 54.74'
- PP W 87.0' C/L biktp. dr. N 0.5' C/L Buccaneer Dr. NW 77' (Perp. Meas.)

B. Description of corner evidence found and/or method applied in restoring or reestablishing corner:


H-8 Did not find the Capped Rerod per LCRC #4908. Established location of corner from all witnesses of LCRC #4908.

Said location is 1.5' S. and 1.1' W. from intersection of 1/4 lines and agrees with adjoining plats and survey measurements of others.

The location per LCRC #4908 is accepted by me and is generally accepted by professional surveyors as the best available evidence of the position of the corner.

C. Description of monument for corner and accessories established to perpetuate locating the position of the corner:

- H-8 Set 1/2" Rerod and "Kent Co. Remon." cap in C/L (±) asph. drwy. as described above.
- Set Nail & KC Remon. tag S. side 16" W. Cherry N90°E 19.28'
- Set Nail & KC Remon. tag W. side 16" Oak N00°W 54.62'
- Set Nail & KC Remon. tag E. side 16" Oak S00°W 54.70'
- PK Nail S. side Power Pole S90°W 87.04'
- Capped Exxel Iron N00°E 17.94'
- C/L Buccaneer Drive (Perp. Meas.) NW 77'

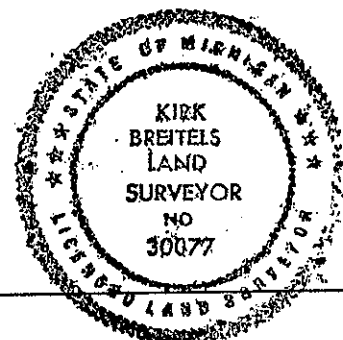

Signed by Kirk Breitels  
Surveyor's Michigan License No. 30077

Date 10/11/96

P.A. 345 1990 KENT COUNTY  
PEER APPROVED 9/26/96  
CHAIRMAN Henry Hubert