

SURVEY & REMONUMENTATION

FEB 14 1997

KENT COUNTY REMONUMENTATION

COMMISSION

LAND CORNER RECORDATION CERTIFICATE
Filing Requirement of Act 74, Mich. P.A. 1970

For corners in
KENT COUNTY
(County)

Located In:	Corner Code #
T 7N R 10W	I-13
T ___ R ___	_____
T ___ R ___	_____
T ___ R ___	_____
T ___ R ___	_____
S ___ T ___ R ___	_____
S ___ T ___ R ___	_____
S ___ T ___ R ___	_____
S ___ T ___ R ___	_____

STATE OF MICHIGAN
COUNTY OF KENT
REGISTERED FOR RECORD
96 OCT 18 AM 8:19
9392
Register of Deeds Stamp & File Number

4. Lot No. _____, Recorded Plat _____
5. Private Claims _____

I, Kirk Breitels, in a field survey on Aug. 25, 1996 do hereby state that under requirements of P.A. 74, Michigan P.A. of 1970, the corner points mentioned in lines 1 and 2 above were in conformance with regulations and rules therefore as required in the current manual of survey instructions of the United States Department of the Interior, Bureau of Land Management or by a decree of a Court of Law and /or that the corner points mentioned in lines 3, 4 and 5 above were in conformance with the rules of the Michigan Board of Land Surveyors or by a Decree of a Court of Law, established, re-established, monumented, recovered, found as expressed below:

A	B	C	D	E	F	G	H	I	J	K	L
1											
2	6		5		4		3		2		1
3											
4	7		8		9		10		11		12
5											
6	18		17		16		15		14		13
7											
8	19		20		21		22		23		24
9											
10	30		29		28		27		26		25
11											
12	31		32		33		34		35		36
13											

NOTE: Not more than 2 corners, all in the same town and range, may be recorded on this certificate.

A. Description of original monument and accessories and/or subsequent restoration:

I-13	1831	GLO	Mullett	Set Post
	1956	Kent Co. Wit.		Witnesses given
	1989	LCRC #5068	Bueche	Set Kent County Monument

The position of this corner was previously approved by the Kent County Remonumentation Peer Group, monumented by John C. Bueche on 4-7-89 and was recorded per LCRC #5068

B. Description of corner evidence found and/or method applied in restoring or reestablishing corner:

I-13 Found NOTHING AT CORNER. Set standard Kent Co. Mon. (Harrison) in the same location per witnesses from above LCRC as set by John C. Bueche in place of the 1/2" x 18" Iron he found. Said Iron checks with Kent Co. Wit.

LCRC #5068


Nail & KC Remon. tag S. side 8" Poplar	N35°W	51.09'
Nail & KC Remon. tag NW side 36" Oak	N35°E	46.05'
Nail & KC Remon. tag N. side P. Pole	S80°E	83.58'
C/L RR track	S45°W	18.00'
KC Mon., NE cor. Sec. 3-6-10	West	67.82'

The selected location is accepted by me and is generally accepted by professional surveyors as the best available evidence of the position of the original corner.

C. Description of monument for corner and accessories established to perpetuate locating the position of the corner.

I-13 Standard Kent County Monument

C/L RR track	S45°W	18.00'
Set Nail & KC Remon. tag E. side P. Pole	S00°E	180.84'
SW'ly cor. brick pillar fnd. (W'ly end of wall)	N20°W	109.22'
NW'ly cor. brick porch	N40°E	106.03'
NW'ly cor. brick pillar fnd. (N'ly end of wall)	N90°E	125.17'
KC Mon., NE cor. Sec. 3-6-10	West	67.82'

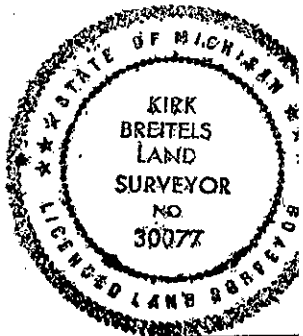

Signed by Kirk Breitels
Surveyor's Michigan License No. 30077

Date 10/11/96

P.A. 345 1990 KENT COUNTY
PEER APPROVED 7/26/96
CHAIRMAN Hans Huber