

\$7.00
\$2.00
SEP 18 1985
COMMISSIONER

KENT COUNTY REMONUMENTATION

LAND CORNER RECORDATION CERTIFICATE
Filing Requirement of Act 74, Mich. P.A. 1970

For corners in
KENT COUNTY
(County)


| Located In: | Corner Code # |
|-------------|---------------|
| T 8N R 12W | I-9 |
| T R | |
| T R | |
| T R | |
| T R | |
| S T R | |
| S T R | |
| S T R | |
| S T R | |

STATE OF MICHIGAN
COUNTY OF KENT
RECEIVED FOR RECORD
95 JUN 29 AM 11:56
REG. OF DEEDS
8487
Register of Deeds Stamp & File Number

4. Lot No. _____, Recorded Plat _____
5. Private Claims _____

I, Kirk Breitels, in a field survey on May 10, 19 95

do hereby certify that under requirements of P.A. 74, Michigan P.A. of 1970, the corner points mentioned in lines 1 and 2 above were in conformance with regulations and rules therefore as required in the current manual of survey instructions of the United States Department of the Interior, Bureau of Land Management or by a decree of a Court of Law and/or that the corner points mentioned in lines 3, 4 and 5 above were in conformance with the rules of the Michigan Board of Land Surveyors or by a Decree of a Court of Law; established, re-established, monumented, re-monumented, recovered, found as expressed below:

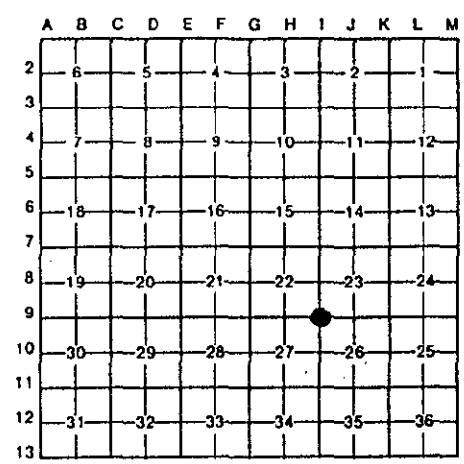

NOTE: Not more than 4 corners, all in the same town and range, may be recorded on this certificate.

A. Description of original monument and accessories and/or subsequent restoration:

| | | | | |
|-----|------|------------------|----------|--------------------------------------|
| I-9 | 1838 | GLO | Whitcomb | Set Post |
| | 1912 | Williams & Works | | Set Stones |
| | 1935 | Kent Co. Wit. | | Iron & Stones |
| | 1966 | Kent Co. Wit. | | RR Spike |
| | 1985 | LCRC #4223 | Bueche | Set Kent County Monument in mon. box |
| | 1990 | LCRC #5395 | Starr | Kent County Monument in mon. box |

The position of this corner was previously approved by the Kent County Remonumentation Peer Group, monumented by Jack C. Bueche on 6/15/86 and was recorded per LCRC #4223.

B. Description of corner evidence found and/or method applied in restoring or reestablishing corner:

I-9 Found standard Kent Co. Mon. (Harrison) per witnesses from above LCRC as set by John C. Bueche in place of the Iron he found inside a mon. box. Said Iron checks with Kent Co. Wit. map measurements and Williams & Works information.

LCRC #4223 & #5395

| | | |
|------------------------------|-------|--------|
| "X" cut on conc. curb return | N40°E | 46.44' |
| "X" cut on conc. curb return | N20°W | 55.47' |
| "X" cut on conc. curb return | N55°W | 55.33' |
| "X" cut on conc. curb return | S75°W | 50.85' |
| "X" cut on conc. curb return | S55°E | 52.93' |
| Top C/L Tele. box | S40°E | 58.68' |

P.A. 345 1990 KENT COUNTY
PEER APPROVED 6/22/95
CHAIRMAN *Harry Hubbell*

The selected location is accepted by me and is generally accepted by professional surveyors as the best available evidence of the position of the original corner.

C. Description of monument for corner and accessories established to perpetuate locating the position of the corner:

| | | |
|---------------------------------------|-------|---------|
| I-9 Standard Kent County Monument | | |
| "X" cut on conc. curb return | N40°E | 46.44' |
| "X" cut on conc. curb return | N20°W | 55.47' |
| "X" cut on conc. curb return | N55°W | 55.33' |
| "X" cut on conc. curb return | S75°W | 50.83' |
| "X" cut on conc. curb return | S55°E | 52.93' |
| Top C/L Tele. box | S40°E | 58.30' |
| Set Nail & Remon. tag NW side P. Pole | N60°E | 142.72' |
| Set Nail & Remon. tag W. side P. Pole | S20°W | 124.27' |



Signed by *Kirk Breitels*
Surveyor's Michigan License No. 30077

Date 6/22/95