

SURVEY & REMONUMENTATION

MAY 22 2000

SECTION

LAND CORNER RECORDATION CERTIFICATE
 Filing Requirement of Act 74, Mich. P.A. 1970
 KENT COUNTY REMONUMENTATION

For corners in

Kent (County)	Located in: Oakfield Township	Corner Code #
1. Public Land Survey	T <u>9N</u> R <u>9W</u>	<u>A-2</u>
	T _____ R _____	_____
	T _____ R _____	_____
	T _____ R _____	_____
2. Property Controlling in Section	S _____ T _____ R _____	_____
	S _____ T _____ R _____	_____
3. Miscellaneous Property in Sec.	S _____ T _____ R _____	_____
	S _____ T _____ R _____	_____

REG. OF DEEDS


STATE OF MICHIGAN
 COUNTY OF KENT
 RECEIVED FOR RECORD
 1999 OCT 15 AM 8:08

11391

Register of Deeds Stamp & File Number

4. Lot No. _____, Recorded Plat _____
 5. Private Claims _____

I, Randy Kolehouse, in a field survey on February 4 19 99, do hereby certify that under requirements of P.A. 74 Michigan P.A. of 1970, the corner points mentioned in lines 1 and 2 above were in conformance with regulations and rules therefore as required in the current manual of survey instructions of the United States Department of the Interior, Bureau of Land Management or by a decree of a Court of Law and/or that the corner points mentioned in lines 3, 4 and 5 above were in conformance with the rules of the Michigan Board of Land Surveyors or by a Decree of a Court of Law; established, re-established, monumented, re-monumented, recovered, found as expressed below:

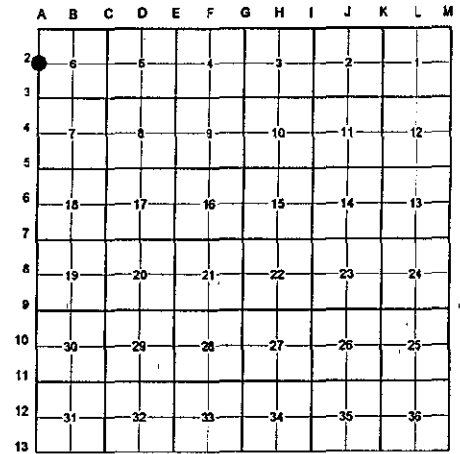

NOTE: Not more than 4 corners, all in the same town and range, may be recorded on this certificate.

A. Description of original monument and accessories and/or subsequent restoration:

A-2	1837	G.L.O. Notes	Cathcart	Set Post
	1934	Witness Map	K.C. Surveyor	Leaded Stone
	1983	L.C.R.C. #3352	Glaza & Associates	N/A (M-2, T9N, R10W)
	1983	L.C.R.C. #3643	John Bueche	Fnd. Leaded Stone & "T" Iron / Set K.C. Monument (M-2, T9N, R10W)
	1991	L.C.R.C. #6221	C. Marschall	K.C. Monument

Note: This corner is common with M-2, T9N, R10W.

This corner was originally approved by the Kent County Remonumentation Peer Group and monumented by John Bueche on 11/14/83 and was recorded per L.C.R.C. #3643.

B. Description of corner evidence found and/or method applied in restoring or reestablishing corner:

A-2 Found a Standard Kent County Monument 5' West of the C/L extended of Ramsdell Drive (gravel) running South and 3' South of the C/L extended of Benham Street (gravel) running West per L.C.R.C.'s #3643 and #6221 as set by John Bueche in place of a leaded stone with an "X" cut and a "T" iron he found which checked L.C.R.C. #3352 and the K.C. Surveyor's records.

L.C.R.C. #3643

K.C. Remon. tag & nail in E. side 8" W. Ch. N 35° W 52.20'
 K.C. Remon. tag & nail in E. side 10" Elm S 20° E 34.41'
 K.C. Remon. tag & nail in N. side 6" W. Ch. S 80° E 52.62'
 N. edge of gravel road South 95'+/-

L.C.R.C. #6221

Nail & Remon Tag in E sd. 4" Cherry S 26 W 4.75' (m. 4.69')
 Nail & Remon Tag in SW sd. 8" Cherry N 40 W 52.35'
 Nail & Remon Tag in NW sd. 8" Cherry N 37 E 28.16' (m. 28.18')
 Centerline S end in cone culvert in stone Hdwl. S 90 W 27.8' (m. 27.94')
 2' Diameter Stone S 45 W 2'
 Centerline Trail to North West 9'

The selected location is accepted by me and is generally accepted by professional surveyors as the best available evidence of the position of the original corner.

C. Description of monument for corner and accessories established to perpetuate locating the position of the corner:

A-2 Standard Kent County Monument

Nail & K.C. remon. tag on E side 6" Cherry S 26° W 4.69'
 Nail & K.C. remon. tag on SW side 10" Cherry N 40° W 52.35'
 Nail & K.C. remon. tag on NW side 10" Cherry N 37° E 28.18'
 C/L S end conc. culv. In stone headwall S 90° W 27.94'
 2' dia. stone S 45° W 2.0'
 C/L of trail to N, West 9.0'

P.A. 345 1990 KENT COUNTY

PEER APPROVED 7/29/99

CHAIRMAN *[Signature]*

Signed by *[Signature]*

Date 9-27-99

WILLIAMS & WORKS

Surveyor's Michigan License No. 25854

