

MAY 22 2000

SECTION

LAND CORNER RECORDATION CERTIFICATE
Filing Requirement of Act 74, Mich. P.A. 1970
KENT COUNTY REMONUMENTATION

For corners in

Kent (County)	Located in: Oakfield Township	Corner Code #
1. Public Land Survey	T <u>9N</u> R <u>9W</u>	<u>B-9</u>
	T _____ R _____	_____
	T _____ R _____	_____
	T _____ R _____	_____
2. Property Controlling in Section	S _____ T _____ R _____	_____
	S _____ T _____ R _____	_____
3. Miscellaneous Property in Sec.	S _____ T _____ R _____	_____
	S _____ T _____ R _____	_____

STATE OF MICHIGAN
COUNTY OF KENT
RECEIVED FOR RECORD

1999 OCT 27 AM 8:35

REG. OF DEEDS

[Signature]


11405

Register of Deeds Stamp & File Number

4. Lot No. _____, Recorded Plat _____
5. Private Claims _____

I, Randy Kolehouse, in a field survey on March 10 19 99, do hereby certify that under requirements of P.A. 74 Michigan P.A. of 1970, the corner points mentioned in lines 1 and 2 above were in conformance with regulations and rules therefore as required in the current manual of survey instructions of the United States Department of the Interior, Bureau of Land Management or by a decree of a Court of Law and/or that the corner points mentioned in lines 3, 4 and 5 above were in conformance with the rules of the Michigan Board of Land Surveyors or by a Decree of a Court of Law; established, re-established, monumented, re-monumented, recovered, found as expressed below:

NOTE: Not more than 4 corners, all in the same town and range, may be recorded on this certificate.

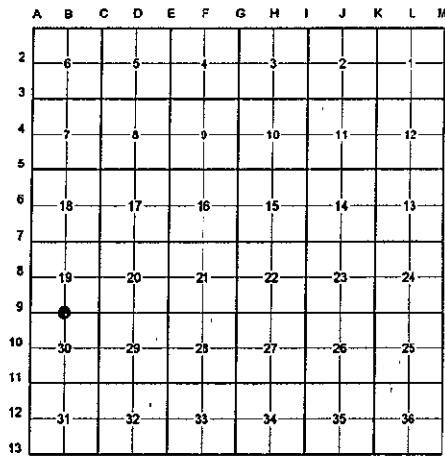

A. Description of original monument and accessories and/or subsequent restoration:

B-9	1837	G.L.O. Notes	Cathcart	Set Post
	1935	Witness Map	K.C. Surveyor	N/A
	1981	L.C.R.C. #2076	Nederveld & Jonker	3/4" Iron in Mon. Box
	1982	L.C.R.C. #2874	Jonker Land Surveys	Fnd. Iron in Mon. Box Over Conc. Mon. / Set K.C. Mon.
	1989	L.C.R.C. #5173	John C. Bueche	K.C. Monument
	1997	L.C.R.C. #9633	Kirk Breitels	K.C. Monument

This corner was originally approved by the Kent County Remonumentation Peer Group and monumented by Rob Jonker on 5/24/82 and was recorded per L.C.R.C. #2874.

B. Description of corner evidence found and/or method applied in restoring or reestablishing corner:

B-9 Found a Standard Kent County Monument 3' North of the C/L intersection of 12 Mile Road (bit.) running East and West and Harvard Avenue running North and 6' ± East of a tree row running South per L.C.R.C.'s #2874, #5173, and #9633 as set by Rob Jonker in place of a 3/4" iron he found in a monument box over a concrete monument 21" below grade which checked L.C.R.C. #2076 and the K.C. Surveyor's records.

L.C.R.C. #2874

Remon. tag on NE side 48" Maple S55°E 60.53'
C/L E. end 15" C.M.P. N30°E 55.4'
C/L W end 15" C.M.P. N15°W 54.2'
"V" in base of concrete pillar in fence S10°W 58.7'

L.C.R.C. #9633

Nail & KC Remon. tag NE side 52" Maple S55°E 60.53'
Nail & KC Remon. tag N. side 32" Maple S65°W 60.26' (m. 60.27')
C/L E. end 15" C.M.P. N30°E 55.4' (m. 55.5')
C/L W. end 15" C.M.P. N15°W 54.2' (m. 54.10')
"V" in NE base conc. pillar (2nd South) 10°W 58.7' (m. 58.73')

The selected location is accepted by me and is generally accepted by professional surveyors as the best available evidence of the position of the original corner.

C. Description of monument for corner and accessories established to perpetuate locating the position of the corner:


B-9 Standard Kent County Monument

Nail & K.C. remon. tag on NE side 52" Maple S 55° E 60.53'
Nail & K.C. remon. tag on N side 32" Maple S 65° W 60.27'
C/L E end 15" CMP N 30° E 55.50'
C/L W end 15" CMP N 15° W 54.10'
"V" in NE base conc. pillar (2nd South) S 10° W 58.73'
On C/L of gravel road running N
C/L bit. road running E-W, South 3'
Tree row running S, West 6'

P.A. 345 1990 KENT COUNTY

PEER APPROVED 7/29/99

CHAIRMAN [Signature]

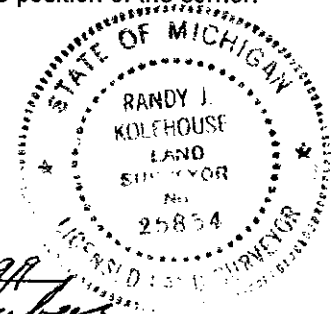

Signed by Randy J. Kolehouse

Date 10-11-99

WILLIAMS & WORKS

Surveyor's Michigan License No. 25854