

MAY 22 2000

\$7.00
\$2.00

SECTION LAND CORNER RECORDATION CERTIFICATE
Filing Requirement of Act 74, Mich. P.A. 1970
KENT COUNTY REMONUMENTATION

For corners in

Kent (County)	Located in:	Oakfield Township	Corner Code #
1. Public Land Survey	T <u>9N</u>	R <u>9W</u>	<u>F-2</u>
	T _____	R _____	_____
	T _____	R _____	_____
	T _____	R _____	_____
2. Property Controlling in Section	S _____	T _____	R _____
	S _____	T _____	R _____
3. Miscellaneous Property in Sec.	S _____	T _____	R _____
	S _____	T _____	R _____

STATE OF MICHIGAN
COUNTY OF KENT
RECEIVED FOR RECORD

1999 DEC 27 AM 8:19

REG. OF DEEDS


11637

Register of Deeds Stamp & File Number

4. Lot No. _____, Recorded Plat _____
5. Private Claims _____

I, Randy Kolehouse, in a field survey on March 22 19 99, do hereby certify that under requirements of P.A. 74 Michigan P.A. of 1970, the corner points mentioned in lines 1 and 2 above were in conformance with regulations and rules therefore as required in the current manual of survey instructions of the United States Department of the Interior, Bureau of Land Management or by a decree of a Court of Law and/or that the corner points mentioned in lines 3, 4 and 5 above were in conformance with the rules of the Michigan Board of Land Surveyors or by a Decree of a Court of Law; established, re-established, monumented, re-monumented, recovered, found as expressed below:

NOTE: Not more than 4 corners, all in the same town and range, may be recorded on this certificate.

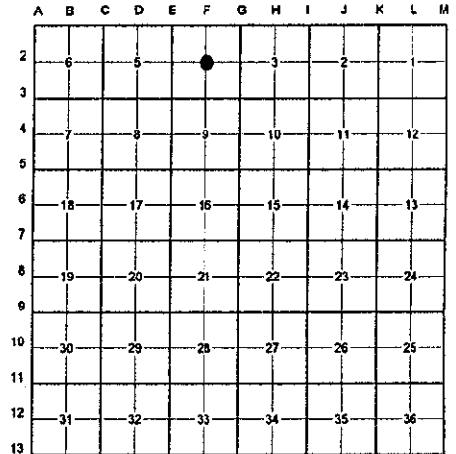

A. Description of original monument and accessories and/or subsequent restoration:

F-2	This corner was not originally set by the G.L.O.	N/A	Witness Map	K.C. Surveyor	Iron
		1894	Survey Records	Williams & Works	Stone
		1946	Survey Records	Williams & Works	Iron & Stone
		1978	L.C.R.C. #1113	James Reda	3/4" Iron

P.A. 345 1990 KENT COUNTY
PEER APPROVED 12/2/99
CHAIRMAN Harry Huber

B. Description of corner evidence found and/or method applied in restoring or reestablishing corner:

F-2 Found a 3/4" iron per L.C.R.C. #1113. The found iron also checks survey records of Williams & Works (1894-1946). Found iron is 1.9' East and 0.1' South of intersection of 1/4 lines. Held the found iron as Center of Section.


L.C.R.C. #1113

- S.E. cor. hse. N. 20° E 104.5' (m. 104.37')
- P.K. in N. sde. 28" Oak S. 24.4' (m. 24.22')
- P.K. in N. sde. 10" & 5" Dbl. Oak S 75° W 119.6' (m. 119.65')
- P.K. in N. sde. 10" Pine S. 3° E 49.9' (m. 50.31')

The selected location is accepted by me and is generally accepted by professional surveyors as the best available evidence of the position of the original corner.

C. Description of monument for corner and accessories established to perpetuate locating the position of the corner:

- F-2 Replaced 3/4" Iron with a Standard Kent County Monument
- Nail & K.C. remon. tag on N side 28" Oak South 24.22'
 - Nail & K.C. remon. tag on N side twin 10" Oaks S 75° W 119.65'
 - Nail & K.C. remon. tag on N side 10" Pine S 03° E 50.31'
 - Nail & K.C. remon. tag on E side 8" Oak N 10° W 18.78'
 - Nail & K.C. remon. tag on SW side 8" Oak S 65° E 96.98'

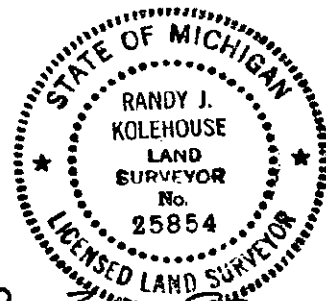

Signed by Randy Kolehouse Date 12-20-99
WILLIAMS & WORKS
Surveyor's Michigan License No. 25854