

SURVEY & REMONUMENTATION

MAY 22 2000

\$7.00
\$2.00

SECTION

LAND CORNER RECORDATION CERTIFICATE
Filing Requirement of Act 74, Mich. P.A. 1970
KENT COUNTY REMONUMENTATION

For corners in

Kent (County)	Located in: Oakfield Township	Corner Code #
1. Public Land Survey	T 9N R 9W	E-10
	T _____ R _____	South Witness
	T _____ R _____	Monument
	T _____ R _____	
2. Property Controlling in Section	S _____ T _____ R _____	
	S _____ T _____ R _____	
3. Miscellaneous Property in Sec.	S _____ T _____ R _____	
	S _____ T _____ R _____	

4. Lot No. _____, Recorded Plat _____
5. Private Claims _____

STATE OF MICHIGAN
COUNTY OF KENT
RECEIVED FOR RECORD
1999 DEC 30 AM 9:20
REG. OF DEEDS
"other" # 11686
Seq 2
Register of Deeds Stamp & File Number

I, Randy Kolehouse, in a field survey on March 22 19 99, do hereby certify that under requirements of P.A. 74 Michigan P.A. of 1970, the corner points mentioned in lines 1 and 2 above were in conformance with regulations and rules therefore as required in the current manual of survey instructions of the United States Department of the Interior, Bureau of Land Management or by a decree of a Court of Law and/or that the corner points mentioned in lines 3, 4 and 5 above were in conformance with the rules of the Michigan Board of Land Surveyors or by a Decree of a Court of Law; established, re-established, monumented, re-monumented, recovered, found as expressed below:

NOTE: Not more than 4 corners, all in the same town and range, may be recorded on this certificate.

A. Description of original monument and accessories and/or subsequent restoration:

E-10 1993 L.C.R.C. #6828A C. Marschall Set K.C. Witness Monument
1997 L.C.R.C. #9665 Kirk Breitels K.C. Witness Monument

This corner was originally approved by the Kent County Remonumentation Peer Group and monumented by C. Marschall in May 1993 and was recorded per L.C.R.C. #6828A.

B. Description of corner evidence found and/or method applied in restoring or reestablishing corner:

E-10 Found a Standard Kent County Witness Monument in Wabasis Park with no occupation North-South or East-West per L.C.R.C.'s #6828A and #9665 as set by C. Marschall South of E-10 and 1090.39' North of E-11.

L.C.R.C. #6828A

Nail and Tag in E. side of 16" Oak S 02° W 26.18'
Nail and Tag in S. side of 18" Oak S 53° W 33.27'
Nail and Tag in W. side of 12" Oak N 52° W 17.21'
Nail and Tag in W. side of 20" Maple N 12° W 60.54'
SE corner Caretaker Building North 273' ±
SW corner bit. parking lot N 16° E 149' ±
Top of Bank South 40' ±
Top of Bank West 130' ±
SE corner Section 29 South 1090.39'

L.C.R.C. #9665

Nail & KC Remon. tag E. side 22" Oak S 02° W 26.18' (m. 26.19')
Nail & KC Remon. tag S. side 24" Oak S 53° W 33.29' (m. 33.19')
Nail & KC Remon. tag W. side 14" Oak N 52° W 17.20' (m. 17.17')
Nail & KC Remon. tag W. side 24" Maple N 12° W 60.59' (m. 60.56')
SE corner caretaker bldg. North 273' ±
SW corner bit. parking lot N 16° E 149' ±
Top of bank - South 40' ± Top of bank - West 130' ±

The selected location is accepted by me and is generally accepted by professional surveyors as the best available evidence of the position of the original corner.

C. Description of monument for corner and accessories established to perpetuate locating the position of the corner:


E-10 Standard Kent County Witness Monument

Nail & K.C. remon. tag on E side 22" Oak S 02° W 26.19'
Nail & K.C. remon. tag on S side 24" Oak S 53° W 33.19'
Nail & K.C. remon. tag on W side 14" Oak N 52° W 17.17'
Nail & K.C. remon. tag on W side 24" Maple N 12° W 60.56'
Nail & K.C. remon. tag on S side 24" Oak N 85° E 29.51'
Top bank S 40' ±, top bank W 130' ±, SW cor. bit parking lot N 16° E 149' ±
SE cor. caretaker's bldg. N 273' ±
K.C. Monument at the SE corner Sec. 29 South 1090.39' ±



Signed by Randy J. Kolehouse Date 12-28-99
WILLIAMS & WORKS

Surveyor's Michigan License No. 25854

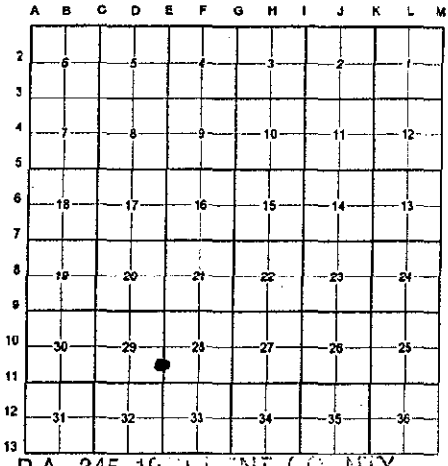

P.A. 345 1999 KENT COUNTY
PEER APPROVED 10/28/99
CHAIRMAN [Signature]