

REMONUMENTATION
 \$7.00
 \$2.00
 18 1995
 COMMISSIONER

KENT COUNTY REMONUMENTATION
 LAND CORNER RECORDATION CERTIFICATE
 Filing Requirement of Act 74, Mich. P.A. 1970

STATE OF MICHIGAN
 COUNTY OF KENT
 RECEIVED FOR RECORD
 95 MAY 12 AM 10:45

W. J. Bond
 REG. OF DEEDS

For corners in
 KENT COUNTY

(County)	Located In:	Corner Code -#
1. Public Land Survey	T <u>10N</u> R. <u>11W</u>	E-11
	T _____ R _____	_____
	T _____ R _____	_____
	T _____ R _____	_____
2. Property Controlling in Section	S _____ T _____ R _____	_____
	S _____ T _____ R _____	_____
3. Miscellaneous Property in Sec.	S _____ T _____ R _____	_____
	S _____ T _____ R _____	_____
4. Lot No. _____, Recorded Plat _____		
5. Private Claims _____		

8391

Register of Deeds Stamp & File Number

I, Kirk Breitels, in a field survey on March 10, 19 95

do hereby certify that under requirements of P.A. 74, Michigan P.A. of 1970, the corner points mentioned in lines 1 and 2 above were in conformance with regulations and rules therefore as required in the current manual of survey instructions of the United States Department of the Interior, Bureau of Land Management or by a decree of a Court of Law and/or that the corner points mentioned in lines 3, 4 and 5 above were in conformance with the rules of the Michigan Board of Land Surveyors or by a Decree of a Court of Law; established, re-established, monumented, re-monumented, recovered, found as expressed below:

NOTE: Not more than 4 corners, all in the same town and range, may be recorded on this certificate.

	A	B	C	D	E	F	G	H	I	J	K	L	M
2	6	5	4	3	2	1							
3													
4	7	8	9	10	11	12							
5													
6	18	17	16	15	14	13							
7													
8	19	20	21	22	23	24							
9													
10	30	29	28	27	26	25							
11													
12	31	32	33	34	35	36							
13													

A. Description of original monument and accessories and/or subsequent restoration:

E-11 1837 GLO Cathcart Set Post
 1973 LCRC #563 VanKooten "T" Iron over 3/4" Iron
 1981 LCRC #2102 Jonker Set Kent County Monument in mon. box
 1994 Glaza Witness Kent Co. Mon. before const.

The position of this corner was previously approved by the Kent County Remonumentation Peer Group, monumented by Robert J. Jonker on 9/9/81 and was recorded per LCRC #2102, P.A. 345 1990 KENT COUNTY

PEER APPROVED 4/27/95
 CHAIRMAN *Harry Huber*

B. Description of corner evidence found and/or method applied in restoring or reestablishing corner:


E-11 Found Large Spike in mon. box (after road const) that fit Glaza witnesses by 0.05' m/l. Set standard Kent Co. Mon. (Harrison) in mon. box per witnesses from Glaza and from above LCRC as set by Robert J. Jonker in place of the "T" Iron he found over a conc. mon. inside a mon. box. Said "T" Iron and conc. mon. checks with LCRC #563.

LCRC #2102
 Remon. tag W. side Tri. 15" Oak N10°W 57.76' (57.27' - Glaza - new nail)
 Remon. tag SW side 16" Oak N60°W 98.88' (99.07' - Glaza - new nail)
 Angle point of top corner fence post South 38.57' (39.53' - Glaza - post leaning)
 Angle point of top corner fence post North 41.75' (41.83' - Glaza)

The selected location is accepted by me and is generally accepted by professional surveyors as the best available evidence of the position of the original corner.

C. Description of monument for corner and accessories established to perpetuate locating the position of the corner:

E-11 Standard Kent County Monument in mon. box
 Remon. tag & nail W. side Tri. 20" Oak N10°W 57.31'
 Remon. tag & nail SW side 20" Oak N60°W 99.03'
 Angle point of top corner fence post S00°W 39.53'
 Angle point of top corner fence post N00°E 41.83'

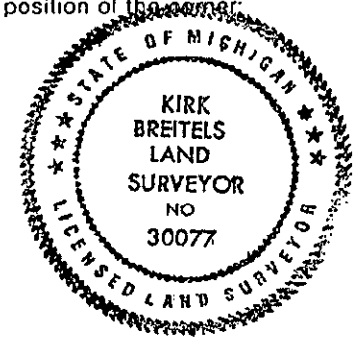

Signed by *Kirk Breitels* Date 4/20/95
 Surveyor's Michigan License No. 30077