

SURVEY & REMONUMENTATION

AUG 22 1995

COMMISSION

LAND CORNER RECORDATION CERTIFICATE

Filing Requirement of Act 74, Mich. P.A. 1970

STATE OF MICHIGAN  
COUNTY OF KALAMAZOO  
RECEIVED FOR RECORD

95 FEB 9 PM 3 58

For corners in SCHOOLCRAFT TWP.  
KALAMAZOO  
(County)

Located In:

Corner Code #

1. Public Land Survey	T <u>4</u> S R <u>11</u> W	<u>D-3</u>
	T _____ R _____	_____
	T _____ R _____	_____
	T _____ R _____	_____
2. Property Controlling in Section	S _____ T _____ R _____	_____
	S _____ T _____ R _____	_____
3. Miscellaneous Property in Section	S _____ T _____ R _____	_____
	S _____ T _____ R _____	_____

*James [Signature]*  
CLERK-REGISTER

LIBER 1 PG 1268

Register of Deeds Stamp & File Number

4. Lot No. \_\_\_\_\_, Recorded Plat \_\_\_\_\_  
5. Private Claims \_\_\_\_\_

I, Allen H. McMachen, a field surveyor on December 29, 19 94, do hereby certify that under requirements of P.A. 74, Michigan P.A. of 1970, the corner points mentioned in lines 1 and 2 above were in conformance with regulations and rules therefore as required in the current manual of survey instructions of the United States Department of the Interior, Bureau of Land Management or by a decree of a Court of Law and/or that the corner points mentioned in lines 3, 4 and 5 above were in conformance with the rules of the Michigan Board of Professional Surveyors or by a Decree of a Court of Law; established, re-established, monumented, re-monumented, recovered, found as expressed below:

**NOTE: Not more than 4 corners, all in the same town and range, may be recorded on this certificate.**

A. Description of original monument and accessories and/or subsequent restoration:

- 1826 - U.S. Government Survey, set  $\frac{1}{4}$  Section Post  
BR. Oak 9" N.  $66^\circ$  E. 218 lks.  
BR. Oak 14" N.  $32\frac{1}{4}^\circ$  E. 234 lks.
- 1889 - F. Hodgeman, C.S., Found stake in center of road and in line with fences N. & S., Set Post  
Locust 6" S. about  $50^\circ$  W. 56 lks.  
Locust 12" S. about  $60^\circ$  W. 93 lks.
- 1908 - E. Strong, C.S., Found Tile from bearing Trees.

B. Description of corner evidence found and/or method applied in restoring or reestablishing corner:


Found Clay Tile 2.5' below surface.

C. Description of monument for corner and accessories established to perpetuate locating the position of the corner:

Found Clay Tile is accepted as a careful and faithful perpetuation of the position of the original corner. Placed Harrison monument over existing Tile and monument box over. Accessories:

- "PK" Nail & Tab in E. side Power Pole NORTH 30.18'
- Nail & Tab in 12" Oak S.  $70^\circ$  E. 94.34'
- Nail & Tab in W. side 8" Double Maple S.  $30^\circ$  W. 30.15'
- Nail & Tab in N. side 18" Walnut S.  $65^\circ$  W. 66.16'

RATIFIED  
BY KALAMAZOO COUNTY  
REMONUMENTATION  
PEER GROUP  
1/19/95  
*R.E.F.*

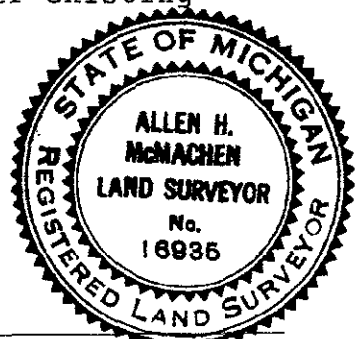

Signed by Allen H. McMachen  
Surveyor's Michigan License No. 16935

Date 2/9/95

