

SURVEY & MONUMENTATION

FEB 26 2001

LAND CORNER RECORDATION CERTIFICATE
Filing Requirement of Act 74, Mich. P.A. 1970

FILED

SECTION
For corners in

<u>LIVINGSTON</u> (County)	Located In:	Corner Code #
1. Public Land Survey	T <u>2</u> N R <u>3</u> E	<u>E-09</u>
	T _____ R _____	_____
	T _____ R _____	_____
	T _____ R _____	_____
2. Property Controlling in Section	S _____ T _____ R _____	_____
	S _____ T _____ R _____	_____
3. Miscellaneous Property in Sec.	S _____ T _____ R _____	_____
	S _____ T _____ R _____	_____


2000 NOV 15 A 9:29
NANCY HAVILAND
REGISTER OF DEEDS
LIVINGSTON COUNTY, MI.
48843

LSC #1368m

9

Register of Deeds Stamp & File Number

4. Lot No. _____, Recorded Plat _____
5. Private Claims _____

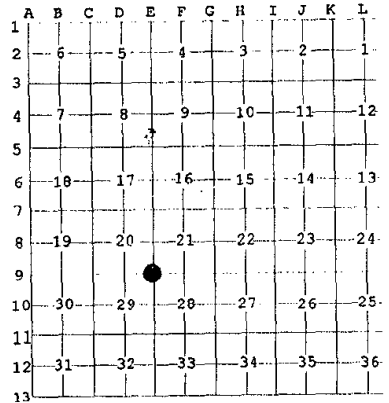

I, DARRELL D. HUGHES, in a field survey on November 7, 2000, do hereby state that under requirements of P.A. 74, Michigan P.A. of 1970, the corner points mentioned in lines 1 and 2 above were in conformance with regulations and rules therefore as required in the current manual of survey instructions of the United States Department of the Interior, Bureau of Land Management or by a decree of a Court of Law and /or that the corner points mentioned in lines 3, 4 and 5 above were in conformance with the rules of the Michigan Board of Land Surveyors or by a Decree of a Court of Law; established, re-established, monumented, recovered, found as expressed below:

NOTE: Not more than 2 corners, all in the same town and range, may be recorded on this certificate.

A. Description of original monument and accessories and/or subsequent restoration:

GLO: 1825, Sylvester Sibley, Deputy Surveyor
White Oak 24 inch diameter, bears South 46-1/2 degrees East, 22 links
White Oak 22 inch diameter, bears North, 17 links

IOSCO TWP.

* ADDITIONAL HISTORICAL INFORMATION ON BACK OF SHEET

B. Description of corner evidence found and/or method applied in restoring or reestablishing corner:

No evidence found. Reestablished by retracement of certified land surveys as recorded in Liber 614, Pages 538 - 550 and Liber 634, Pages 43 - 55, Livingston County Records.

P.A. 345 1990, APPROVED BY LIVINGSTON COUNTY
REFER GROUP ON 9-20-00 CORNER JED

C. Description of monument for corner and accessories established to perpetuate locating the position of the corner:

E-09, T2N, R3E, IOSCO, set break-away pipe with brass cap, stamped "Livingston Co. Monumentation Corner, P.S. 19834," 2 ft below grade and is accepted as a careful and faithful reestablishment of the position of the original corner.

- WEST 850 FT. +/- FROM FARM LANE GATE - CARSONITE MARKER 6.5 FT SOUTH OF CORNER
- 180 DEG. 11.5' SET 1" WITNESS PIPE/BRASS CAP 2 FT BELOW GRADE C/L OF E/W FARM LANE
- 135 DEG. 19.02' SET 1" WITNESS PIPE/BRASS CAP 2 FT BELOW GRADE IN C/L FARM LANE
- 242 DEG. 21.53' SET 1" WITNESS PIPE/BRASS CAP 2 FT BELOW GRADE IN C/L FARM LANE
- 315 DEG. 19.96' SET 1" WITNESS PIPE/BRASS CAP 2 FT BELOW GRADE IN FARM FIELD
- 054 DEG. 19.35' SET 1" WITNESS PIPE/BRASS CAP 2 FT BELOW GRADE IN FARM FIELD

Signed by Darrell Hughes
Surveyor's Michigan License No. 19834

Date November 7, 2000