

1993

FILED

COMMISSION

LAND CORNER RECORDATION CERTIFICATE

Filing Requirement of Act 74, Mich. P.A. 1970

DEC 24 AM '93

For corners in

LIVINGSTON

(County)

Located In:

Corner Code ##

1. Public Land Survey

T 4N R 3E

K-12

T R

T R

T R

2. Property Controlling in Section

S T R

S T R

3. Miscellaneous

S T R

Property in Sec.

S T R

NANCY HAVILAND REGISTER OF DEEDS LIVINGSTON COUNTY, MI 48843

L.S.C.# 64m

Register of Deeds Stamp & File Number

4. Lot No. , Recorded Plat

5. Private Claims

	A	B	C	D	E	F	G	H	I	J	K	L	M
2	6		5		4		3		2				
3													
4	7		8		9		10		11		12		
5													
6	18		17		16		15		14		13		
7													
8	19		20		21		22		23		24		
9													
10	30		29		28		27		26		25		
11													
12	31		32		33		34		35		36		
13													

I, Donald G. Richards, in a field survey on October 19, 1993, do hereby certify that under requirements of P.A. 74, Michigan P.A. of 1970, the corner points mentioned in lines 1 and 2 above were in conformance with regulations and rules therefore as required in the current manual of survey instructions of the United States Department of the Interior, Bureau of Land Management or by a decree of a Court of Law and/or that the corner points mentioned in lines 3, 4 and 5 above were in conformance with the rules of the Michigan Board of Land Surveyors or by a Decree of a Court of Law; established, re-established, monumented, re-monumented, recovered, found as expressed below:

NOTE: Not more than 4 corners, all in the same town and range, may be recorded on this certificate.

A. Description of original monument and accessories and/or subsequent restoration:


Sylvester Sibley, February 18th, 1825 "40.00 (chains) set quarter post from which a White Oak 25" diameter bears N 38 W 29 links distant a White Oak 22" diameter bears S 41 E 50 links distant"

B. Description of corner evidence found and/or method applied in restoring or reestablishing corner:

Found 1/2" Iron Rod with cap No. 12024 2' West of east edge of gravel road (see reverse side for research and investigation summary)

C. Description of monument for corner and accessories established to perpetuate locating the position of the corner:

Re-set with 1 1/4" x 36" iron pipe w/brass cap stamped "Livingston County Remonumentation Corner" S 80 W 74.45' nail/LCWT* in S face 16" Box Elder N 15 E 60.65' nail/LCWT in W face 46" Oak S 80 E 29.45' nail/LCWT in N face 15" Maple S 30 E 73.30' nail/LCWT in W face 37" Maple (* Livingston County Witness Tag)

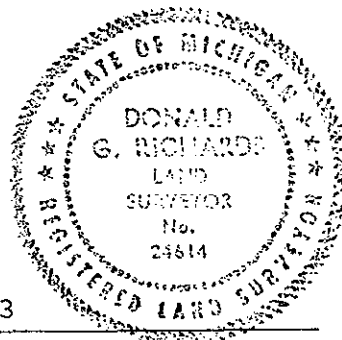

Signed by DONALD G. RICHARDS

[Handwritten signature]

Date December 10, 1993

Surveyor's Michigan License No. 24614

APPROVED by Livingston County Monumentation Peer Group 11-23-93

CONWAY K-12

This quarter corner was first established in the winter of 1825 by Deputy Surveyor Sylvester Sibley.

County surveyor records of 1968 provide three ties to this point but do not identify the material marking the corner. Records indicate the point was centered on N-S running fences 50' apart and slightly South of an East running fence. These records show this point to be 2661 p/m north of the SW corner of the section.

Apparently, however, it was difficult to relocate this point. In a survey in 1979, A.F. Miller sets and records the E 1/4 corner of Section 35. He is, however, 2673 p/m North of the the South section line.

Recent survey by Charles Garlock in 1992 utilizes Miller's corner as the quarter corner.

On October 19, 1993 fieldcrews recovered Miller's rerod and cap denoting this quarter corner. The rerod lies a foot and a half West of the East edge of a gravel road although further to the North, it fits the centerline of the gravel road. There is no apparent occupation to the West, and nothing to the East for at least a quarter mile. None of the recorded witness ties could be located, however, the location of this point between corners K-11 and K-13 compares favorably with that noted by Miller'79 and Garlock'92.

Donald G. Richards PS 24614
November 18, 1993