

MICHIGAN
DEPARTMENT OF CONSERVATION
FORESTRY DIVISION

LAND CORNER RECORD

T. 43 N. R. 7W


Mackinac COUNTY

DESCRIPTION OF CORNER Sec. Cor. common to 9-10-15-16

CORNER MONUMENT 1 1/2" x 30" iron pipe buried in road.

DATE MONUMENT PLACED AND WITNESSED 4/29/65

WITNESSES TO CORNER..... 5" Hard maple (NBT) N39°W 65.5'

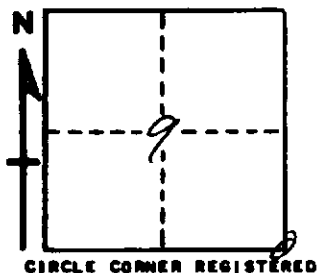

9" Aspen (NBT) S63°W 59.0'

AND

DESCRIPTION IN DETAIL AS TO HOW CORNER WAS LOCATED AND IDENTIFIED OR RESTORED.

Corner placed 33.0' to west of fence corner and
fence line to East.
Position checks well with corners to West and
North.

SURVEYOR'S SEAL

Billy D. Buckler
SIGNED Billy D. Buckler, R. L. S. DATE 9/12/68
REGISTERED LAND SURVEYOR