

LAND CORNER RECORDATION CERTIFICATE

FILING REQUIREMENT OF ACT 74, MICH. P.A.1970

FOR CORNERS OF --: LOCATED IN --:

1. PUBLIC LAND SURVEY _____ T. 20N N. 15W E. S., R. W.

2. PROPERTY CONTROLLING IN SECTION _____ T. _____ N. _____ E. S., R. W.

3. MISCELLANEOUS PROPERTY IN SECTION _____ T. _____ N. _____ E. S., R. W.

4. LOT NO. _____, RECORDED PLAT _____

5. PRIVATE CLAIMS _____

CORNER CODE NUMBER AT 10:10 O'CLOCK a

C3

Seg. # 2

FILED

NOV 17 1994

MARY GOLDEN KOLASKI
MASON COUNTY
REGISTER OF DEEDS

REGISTER OF DEEDS STAMP AND FILING NUMBER

I, Patrick R. Leemon do hereby certify that under requirements of P.A. 74, Michigan P.A. of 1970, the corner points mentioned in lines 1 and 2 above (identified with circles on index code diagram - over) were, in a field survey on October 30, 1994, established, re-established, monumented, re-monumented, recovered or restored as expressed below and in conformance with regulations and rules therefore as required in the current manual of survey instructions of the United States Department of the Interior, Bureau of Land Management or by a decree of a court of law. Furthermore, that the corner points mentioned in lines 3, 4 and 5 above were, in a field survey on _____, 19____, found, recovered, restored, established or re-established as expressed below and in conformance with the rules of the Michigan State Board of Registration for Land Surveyors or, by a Decree of a Court of law:

A. Description of original monument and accessories and/or subsequent restoration:

Section corner common to sections 5, 6, 7 and 8 of T20N R15W

<p>1839 survey by John Brink Set Wood Post #1 Pine 12 N61E 136 links #2 Pine 12 S74E 79 links</p>	<p>1918 survey by C.E. Mitchell Co. Sur. Set Concrete Monument #3 Pine 18 N47.30E 9 links #4 Pine 11 S20W 14 links</p>	<p>1971 survey by Robert A. Griffin #13584 Searched for and found the concrete monument by Mitchell. Replaced it w/ a 5" sq. by 60" long conc. monument w/ 3" brass cap #6 B.Oak 14 North 145.50 feet #7 W.Oak 10 N74E 36.40 feet #8 W.Oak 9 S14W 17.24 feet #9 P.Post 4 West 1.55 feet</p>
<p>1942 Search by H. Dollmeyer USFS Fd. concrete monument #5 cedar Post 6 South 1 link</p>		

B. Description of corner evidence found and/or method applied in restoring or re-establishing corner:
I found the 5" square by 60" long concrete monument w/ brass cap by Griffin 257 feet South of the centerline of the E-W trail road. Witnesses 1 through 4 and 6 are gone. Witness 7 through 9 are in good condition. Witness #5 has fallen over. Liber 1 Page 80 by Griffin documents the history of this corner. I could find no conflicting information that would lead to another location. This monument is accepted as the best available evidence of the position of the original corner.

Peer Group Reviewed and Approved
Date: 11-16-94
Kenneth L. Ross
Mason County Surveyor

C. Description of monument for corner and accessories established to perpetuate locating the position of the corner:

Section corner common to sections 5, 6, 7 and 8 of T20N R15W

Monu. The 5" square by 36" long concrete monu. with 3" brass disk was left in place
Witnesses:
W.Oak 16 N2W 163.99 feet
B.Oak 10 N54W 39.46 feet
W.Oak 11 N74E 36.37 feet (#7)
W.Oak 10 S19W 17.28 feet (#8)
P.Post 4 West 1.55 feet (#9)

Peer Group Reviewed and Approved
Date: 11-16-94
Kenneth L. Ross
Mason County Surveyor


SIGNED BY *Patrick R. Leemon* DATE October 30, 1994
31595

SURVEYOR'S MICHIGAN REGISTRATION NO. _____

FOR STATE AND UNITED STATES AGENCIES:

SIGNED BY _____ DATE _____
CHIEF OF SURVEY PARTY

APPROVED AND SIGNED BY _____ DATE _____
MICHIGAN REGISTERED LAND SURVEYOR

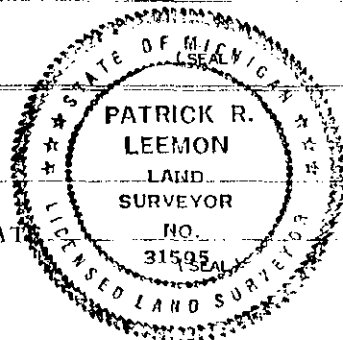

LIBER 3 PAGE 200

SURVEYOR'S MICHIGAN REGISTRATION NO. _____