

REMON. COR. F-5, MT. HALEY TWP.  
LAND CORNER RECORDATION CERTIFICATE  
Filing Requirement of Act 74, Mich. P.A. 1970

For corners in  
Midland  
(County)

	Located in:	Corner Code #
	T <u>13N</u> R <u>1E</u>	<u>F-5</u>
1. Public Land Survey	T ___ R ___	_____
	T ___ R ___	_____
	T ___ R ___	_____
2. Property Controlling in Section	S ___ T ___ R ___	_____
	S ___ T ___ R ___	_____
3. Miscellaneous Property in Sec.	S ___ T ___ R ___	_____
	S ___ T ___ R ___	_____

STATE OF MICHIGAN  
MIDLAND COUNTY  
REMONUMENTATION & FILED

12/15/1999 8:26:43 AM

SCOTT I. HAINES  
REGISTER OF DEEDS

Register of Deeds Stamp & File Number

- 4. Lot No. \_\_\_\_\_, Recorded Plat \_\_\_\_\_
- 5. Private Claims \_\_\_\_\_

I, RODNEY CLAYPOOL, in a field survey on August 16, 1999, do hereby certify that under requirements of P.A. 74, Michigan P.A. of 1970, the corner points mentioned on lines 1 and 2 above were in conformance with regulations and rules therefore as required in the current manual of survey instructions of the United States Department of the Interior, Bureau of Land Management or by a decree of a Court of Law and/or that the corner points mentioned in lines 3, 4 and 5 above were in conformance with the rules of the Michigan Board of Land Surveyors or by a Decree of a Court of Law; re-established, monumented, re-monumented, recovered, found as expressed below:

NOTE: Not more than 2 corners, all in the same town and range, may be recorded on this certificate.

A	B	C	D	E	F	G	H	I	J	K	L	M
2	6	5	4	3	2	1						
3												
4	7	8	9	10	11	12						
5												
6	18	17	16	15	14	13						
7												
8	19	20	21	22	23	24						
9												
10	30	29	28	27	26	25						
11												
12	31	32	33	34	35	36						
13												

A. Description of original monument and accessories and/or subsequent restoration:

F-5 1/4 Corner common to Sections 9 and 16

- Survey by Glo, 1830's, set post
- Survey by F. Gibbs, 1909, 1915, set oak post
- Survey by D. Whittier, 1967, 1968, set pipe at CSR Distance on straight line on fence line
- Survey by M. Hunter, 1968
- Survey by J. Schafer, 1971, 1972, found
- Survey by D. Ledy, 1993, found 1/2" rod

B. Description of corner evidence found and/or method applied in restoring or reestablishing corner:

F-5 1/4 Corner common to Sections 9 and 16


Found 3/4" pipe per surveys by D. Whittier, M. Hunter and J. Schafer

C. Description of monument for corner and accessories established to perpetuate locating the position of the corner:

F-5 1/4 Corner common to Sections 9 and 16

Found 3/8" pipe, replaced pipe with 5/8" rod and brass cap stamped Midland Co. Remon Cor PS 29241, in monument box, and is accepted as the best available evidence of the position of the accepted corner.

- N 70 Deg W, 72.40, nail and plastic disc in 10" Oak
- S 70 Deg W, 72.93, nail and plastic disc in 6" Pine
- S 15 Deg W, 45.38, nail in 12" pine
- N 20 Deg W, 39.59', nail and plastic disc in 10" Oak
- Measured 2445.83' to E-5 and 2658.44' to G-5

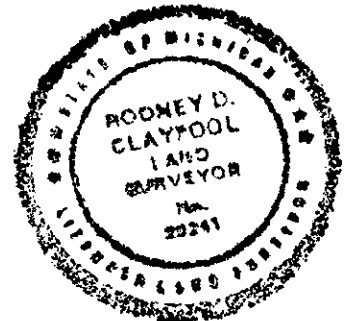

Signed by Rodney D. Claypool  
Surveyor's Michigan License No. 29241

Date 12-11-99  
Form approved by Michigan State Board of Land Surveyors, Jan. 28, 1971  
Revised May 14, 1971  
Revised Jan., 1983

APPROVED LAND CORNER  
P.A. 345 OF 1990  
MIDLAND COUNTY

SURVEY &  
REMONUMENTATION

FEB 09 2000

SECTION

11/03/99