

APPROVED LAND CORNER  
P.A. 345 OF 1990  
MIDLAND COUNTY

SURVEY &  
REMONUMENTATION

REMON. COR. C-10, LARKIN TWP.  
LAND CORNER RECORDATION CERTIFICATE  
Filing Requirement of Act 74, Mich. P.A. 1970

FEB 24 1998

SECTION 327

For corners in  
Midland

(County)	Located in:	Corner Code #
1. Public Land Survey	T <u>15N</u> R <u>2E</u>	<u>C-10</u>
	T ___ R ___	_____
	T ___ R ___	_____
	T ___ R ___	_____
2. Property Controlling in Section	S ___ T ___ R ___	_____
	S ___ T ___ R ___	_____
3. Miscellaneous Property in Sec.	S ___ T ___ R ___	_____
	S ___ T ___ R ___	_____
4. Lot No. _____, Recorded Plat _____		
5. Private Claims _____		

STATE OF MICHIGAN  
MIDLAND COUNTY  
REMONUMENTATION & FILED

8 DEC 97 11:05 A.M.

BEVERLY J THAYER  
REGISTER OF DEEDS

Register of Deeds Stamp & File Number

I, RODNEY CLAYPOOL, in a field survey on Feb 12, 1996, do hereby certify that under requirements of P.A. 74, Michigan P.A. of 1970, the corner points mentioned on lines 1 and 2 above were in conformance with regulations and rules therefore as required in the current manual of survey instructions of the United States Department of the Interior, Bureau of Land Management or by a decree of a Court of Law and/or that the corner points mentioned in lines 3, 4 and 5 above were in conformance with the rules of the Michigan Board of Land Surveyors or by a Decree of a Court of Law; re-established, monumented, re-monumented, recovered, found as expressed below:


**NOTE: Not more than 2 corners, all in the same town and range, may be recorded on this certificate.**

	A	B	C	D	E	F	G	H	I	J	K	L	M
2	6	5	4	3	2	1							
3													
4	7	8	9	10	11	12							
5													
6	18	17	16	15	14	13							
7													
8	19	20	21	22	23	24							
9													
10	30	29	28	27	26	25							
11													
12	31	32	33	34	35	36							
13													

A. Description of original monument and accessories and/or subsequent restoration:

C-10 Corner common to Sections 29 and 30

Survey by Government (H. Park) 1831  
4/6/1937 witness card from Hunter-Whittier records,  
Hunter found spike near large stone  
1955, survey by Hunter, found corner  
1972, H-W recorded survey by J. Schafer, L-1, P-229  
1989, Ayres Associates Sec sheet, found 3/4" pipe in  
4" wood stake, 24" deep, stones around axe head

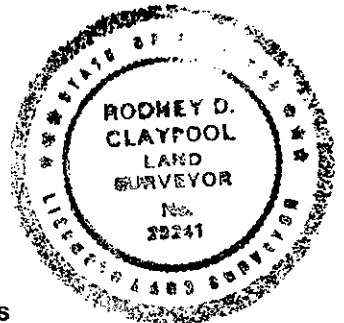

WITNESS NOTE: Witnesses from above surveys and LCRC's are available in dossier file; which was presented to peer review committee and is on file at the Register of Deeds Office.

B. Description of corner evidence found and/or method applied in restoring or reestablishing corner:

C-10 Corner common to Sections 29 and 30

Found 3/4" pipe per surveys by Hunter-Whittier and Ayres Associates

Corner C-10 was approved for remonumentation at a Peer Review Committee Meeting on August 8, 1997.

C. Description of monument for corner and accessories established to perpetuate locating the position of the corner:

C-10 Corner common to Sections 29 and 30

Found 3/4" pipe, replaced with 3/4" pipe and brass cap stamped Midland Co. Remon Cor. PS 29241, per surveys by Hunter-Whittier and Ayres Associates; and is accepted to be the best available evidence of the position of the original corner.

N 40 Deg W, 92.46', nail and tag in 36" Maple (R)  
N 88 Deg W, 42.19', nail and tag in powerpole  
S 85 Deg E, 47.96', nail and plastic disc in twin 8" Elm  
S 60 Deg E, 49.80', nail and plastic disc in 8" Pine  
East 1.0', centerline road

Signed by Rodney D. Claypool

Date 11-26-97

Surveyor's Michigan License No. 29241

Form approved by Michigan State Board of Land Surveyors, Jan. 28, 1971

Revised May 14, 1971

Revised Jan., 1983