

66

LAND CORNER RECORDATION CERTIFICATE
Filing Requirement of Act 74, Mich. P.A. 1970

For corners in

Marquette
(County)

Located In:

Corner Code //

- 1. Public Land Survey T 43N R 25W D-2, D-3, E-3
2. Property Controlling in Section S T R
3. Miscellaneous Property in Sec. S T R


Register of Deeds Stamp & File Number

- 4. Lot No. Recorded Plat
5. Private Claims

I, Paul Bressette, in a field survey on June 15, 1994

do hereby certify that under requirements of P.A. 74, Michigan P.A. of 1970, the corner points mentioned in lines 1 and 2 above were in conformance with regulations and rules therefore as required in the current manual of survey instructions of the United States Department of the Interior, Bureau of Land Management or by a decree of a Court of Law and/or that the corner points mentioned in lines 3, 4 and 5 above were in conformance with the rules of the Michigan Board of Land Surveyors or by a Decree of a Court of Law; established, re-established, monumented, re-monumented, recovered, found as expressed below:

NOTE: Not more than 4 corners, all in the same town and range, may be recorded on this certificate.

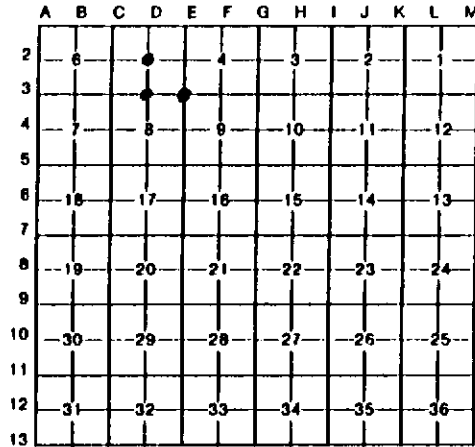

A. Description of original monument and accessories and/or subsequent restoration:

-2 Center quarter corner of Section 5. 1974: 4 inch square concrete monument shown on Certificate of Survey by RLS 19616.

-3 Quarter corner common to Sections 5 and 8. 1852: Martin M. Hall, D.S., set wood post witnessed by Sugar 18" N72W 22 links; Sugar 12" S41E 16 links.

-3 Section corner common to Sections 4, 5, 8 and 9. 1950: Michigan Dept. of Conservation. Set 1" iron pipe with brass cap witnessed by: 10" spruce N01E 35 links; 5" balsam S52E 37 links; 9" spruce N78W 74 links.

B. Description of corner evidence found and/or method applied in restoring or reestablishing corner:


-2 Found concrete monument and witnesses as described. Rejected monument as corner as it is 13.6 feet easterly of position shown on Certificate of Survey and calculated position. Set DNR monument and witnessed.

-3 No evidence of original survey or subsequent restoration found. Corner position re-established mid-point and on-line between the Southeast and Southwest corners of Section 5. Corner falls in approximate centerline of gravel road.

-3 Found monument and the spruce NBT to the Northwest. Spruce is now a dead snag. Rewitnessed monument as found. Corner falls in a clearcut. One BT dead - 8" Spruce NW.

C. Description of monument for corner and accessories established to perpetuate localizing the position of the corner:

Table with 3 columns: D-2 DNR Monument, D-3 with plastic cap, E-3 brass cap. Rows list various monuments like 6" Spruce, 5" Aspen, 9" Spruce, 7" Aspen with bearings and distances.

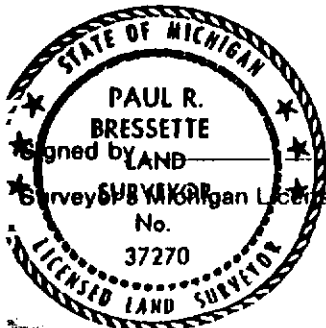

Paul R. Bressette Date

37270