

LAND CORNER RECORDATION CERTIFICATE
Filing Requirement of Act 74, Mich. P.A. 1970

For corners in
Marquette
(County)

Located In:

Corner Code ##

- | | | |
|------------------------------------|-------------|------------------|
| 1. Public Land Survey | T 47N R 23W | A-9, A-10, C-10. |
| | T R | |
| | T R | |
| | T R | |
| 2. Property Controlling in Section | S T R | |
| | S T R | |
| 3. Miscellaneous Property in Sec. | S T R | |
| | S T R | |

Register of Deeds Stamp & File Number

4. Lot No. _____, Recorded Plat _____
 5. Private Claims _____

I, Paul Bressette, in a field survey on 6/3, 19 92, do hereby certify that under requirements of P.A. 74, Michigan P.A. of 1970, the corner points mentioned in lines 1 and 2 above were in conformance with regulations and rules therefore as required in the current manual of survey instructions of the United States Department of the Interior, Bureau of Land Management or by a decree of a Court of Law and/or that the corner points mentioned in lines 3, 4 and 5 above were in conformance with the rules of the Michigan Board of Land Surveyors or by a Decree of a Court of Law; established, re-established, monumented, re-monumented, recovered, found as expressed below:

NOTE: Not more than 4 corners, all in the same town and range, may be recorded on this certificate.

	A	B	C	D	E	F	G	H	I	J	K	L	M
2	6	5	4	3	2	1							
3													
4	7	8	9	10	11	12							
5													
6	18	17	16	15	14	13							
7													
8	19	20	21	22	23	24							
9													
10	30	29	28	27	26	25							
11													
12	31	32	33	34	35	36							
13													

A. Description of original monument and accessories and/or subsequent restoration:


- A-9. Section corner common to Sections 24, 25, 19 and 30. 2" iron pipe recorded in L. 1 p.599, Survey maps by RLS 27464.
- A-10. Quarter corner common to Sections 24 and 30. W.A. Burt, D.S. 1845. Set wood post, Tamarack 9, N28E, 14; Tamarack 12, N47W, 65.
- C-10. Quarter corner common to Sections 29 and 30. A.D. Sullivan, D.S. 1852. Set wood post, hemlock 8, N53W, 23L; Cedar 7, S40E, 9 L.; W. Burt Examiner of Surveys, 1854, Hemlock 6, N54W, 23L; Cedar 6, S45E, 10L.

B. Description of corner evidence found and/or method applied in restoring or reestablishing corner:

- A-9. Found 2" iron pipe and witnesses as described in L. 1, p.599, Survey maps. Replaced found pipe with DNR monument and blazed upper and lower faces on NBTs. Measurements to notch in lower face.
- A-10. Found 1" iron pipe, tamarack stub NE with axe marks and tamarack stump NW in proper position for OBTs. Excavation at pipe revealed 3 stake points, one considerably older than others. Set DNR monument at point of old stake.
- C-10. No evidence of OBTs or subsequent reestablishment found. Corner reestablished mid-point and on line between the northeast and southeast corners of Section 30.

C. Description of monument for corner and accessories established to perpetuate locating the position of the corner:

- | | | |
|-------------------------|--------------------------|--------------------------|
| A-9. DNR Monument | A-10. DNR Monument | C-10. DNR Monument |
| 10" sugar, N45E, 38.25' | 5" tamarack, N31E, 18.2' | 6" hemlock, N84E, 23.25' |
| 4" sugar, S33E, 38.75' | 6" tamarack, S31E, 4.3' | 5" cedar, S26E, 17.5' |
| 8" sugar, S49W, 22.4' | 6" tamarack, S83W, 8.25' | 5" cedar, S46W, 31.4' |
| 10" sugar, N6W, 38.6' | 6" tamarack, N01W, 16.6' | 10" cedar, N31W, 12.9' |

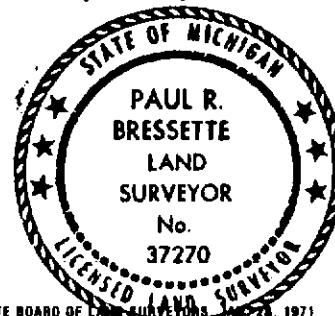

Signed by Paul R. Bressette
 Surveyor's Michigan License No. 37270

Date 9-28-92