

JOB NUMBER: 95053
SHEET NO. : 1-599

APR 01 1996 LAND CORNER RECORDATION CERTIFICATE

Filing Requirement of Act 74, Mich. P.A. 1970

COMMISSION

For corners in

MARQUETTE (County)

Located In:

Corner Code #


- 1. Public Land Survey T 48N R 25W D-5
T _____ R _____
T _____ R _____
T _____ R _____
- 2. Property Controlling S _____ T _____ R _____
in Section S _____ T _____ R _____
- 3. Miscellaneous S _____ T _____ R _____
Property in Section S _____ T _____ R _____

- 4. Lot No. _____, Recorded Plat _____
- 5. Private Claims _____

MARQUETTE COUNTY
RECEIVED FOR RECORD
1995 DEC 27 AM 7:47
REGISTERED PROFESSIONAL SURVEYOR
Gerald W. Carlson

LIBER 1 PAGE 272
Register of Deeds Stamp & File Number

I, GERALD W. CARLSON, in a field survey on Tuesday, October 24, 1995, do hereby certify that under requirements of P.A. 74, Michigan P.A. of 1970, the corner points mentioned in lines 1 and 2 above were in conformance with regulations and rules therefor as required in the current manual of survey instructions of the United States Department of the Interior, Bureau of Land Management or by a decree of a Court of Law and/or that the corner points mentioned in lines 3, 4 and 5 above were in conformance with the rules of the Michigan Board of Professional Surveyors or by a Decree of a Court of Law; established, re-established, monumented, re-monumented, recovered, found as expressed below:

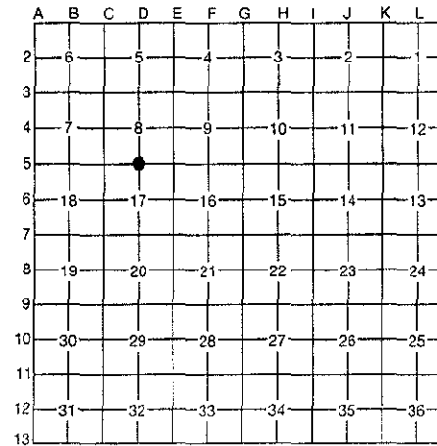

NOTE: Not more than 4 corners, all in the same town and range, may be recorded on this certificate.

A. Description of original monument and accessories and/or subsequent restoration:

D-5: Quarter Corner common to Sections 8 and 17. 1846: William Ives' original survey notes describe the corner monument as a wood post referenced by:
 16" Hemlock N79W, 16 l
 22" Hemlock S63E, 17 l
 found 1 3/4" iron pipe referenced by:
 10" J. Pine N75W, 25.40'
 10" J. Pine N82E, 10.60'
 6" Maple S18.5W, 23.60'
 1990: The corner is shown on an Easement Description Map recorded by Sundberg, Carlson, and Associates in L. 132, MR Pg. 447. No accessories given.
 1895: George P. Cummings, County Surveyor, in Record of Survey Pg. 129, indicates the corner as a wood post 2648' West of the S.E. Corner of Section 8. No accessories given.
 1975: A Certificate of Survey recorded by Robert F. Cambensy RLS # 19616 in L. 1, SM Pg. 127, indicates the corner as a

B. Description of corner evidence found and/or method applied in restoring or reestablishing corner:

1995: Found and accepted a 1 1/2" I.D. pipe at South side of Powerline R.O.W. with 4 blazed trees and a short drill rod sign next to it. Distance East is 2628.21', and Distance West is 2733.49'. Corner is 800'+/- East of Forestville Road.

ATTESTED BY PEER GROUP
P.A. 345 OF 1990

Larry J. Busse
DATE Oct. 23, 1995

C. Description of monument for corner and accessories established to perpetuate locating the position of the corner:

1995: Replaced found pipe with a 2 3/8" diameter Aluminum Pipe with a 3 1/4" diameter Aluminum Tablet Marquette County Survey Monument, 0.1' above ground, stamped to identify the corner. Found existing references with double headed nails in:
 14" J. Pine S87E, 10.36'
 6" W. Pine S32E, 29.20'
 8" Maple S24W, 23.54' Cambensy NBT
 11" J. Pine N77W, 25.35' Cambensy NBT
 Set Green Steel Post w/Yellow Survey Marker Sign S05W, 1.0'
 Note: Repainted existing blazes, added butt blazes, and affixed stamped B.T. Tags to bearing trees.
 Bk. 11, Pg. 33.

Signed by Gerald W. Carlson

Date 11-13-95

Surveyor's Michigan License No. 24589

