

MAR 29 2000

SECTION

LAND CORNER RECORDATION CERTIFICATE  
Filing Requirement of Act 74, Mich. P.A. 1970

Approved by Menominee County  
Land Survey Remonumentation  
Peer Group Under Act 345 Of

P.A. of 1999 On 12/23 1999

*W. Lenca* PLS

Bk. 6 Pg. 62

RECEIVED FOR RECORD  
28 DEC 1999 3:56:09 PM  
BARBARA MORRISON  
REGISTER OF DEEDS  
MENOMINEE, MI 49858

Register of Deeds Stamp & File Number


For corners in

MENOMINEE (County)	Located In:	Corner Code #
1. Public Land Survey	T <u>35</u> NR <u>28</u> W	<u>G-09</u>
	T <u>   </u> R <u>   </u>	<u>   </u>
	T <u>   </u> R <u>   </u>	<u>   </u>
	T <u>   </u> R <u>   </u>	<u>   </u>
2. Property Controlling in Section	S <u>   </u> T <u>   </u> R <u>   </u>	<u>   </u>
	S <u>   </u> T <u>   </u> R <u>   </u>	<u>   </u>
3. Miscellaneous Property in Sec.	S <u>   </u> T <u>   </u> R <u>   </u>	<u>   </u>
	S <u>   </u> T <u>   </u> R <u>   </u>	<u>   </u>

4. Lot No. \_\_\_\_\_, Recorded Plat \_\_\_\_\_  
5. Private Claims \_\_\_\_\_

I, William Lenca, in a field survey on Nov., 19 99 do hereby state that under requirements of P.A. 74, Michigan P.A. of 1970, the corner points mentioned in lines 1 and 2 above were in conformance with regulations and rules therefore as required in the current manual of survey instructions of the United States Department of the Interior, Bureau of Land Management or by a decree of a Court of Law and/or that the corner points mentioned in lines 3, 4 and 5 above were in conformance with the rules of the Michigan Board of Land Surveyors or by a Decree of a Court of Law; established, re-established, monumented, recovered, found as expressed below:

NOTE: Not more than 2 corners, all in the same town and range, may be recorded on this certificate.

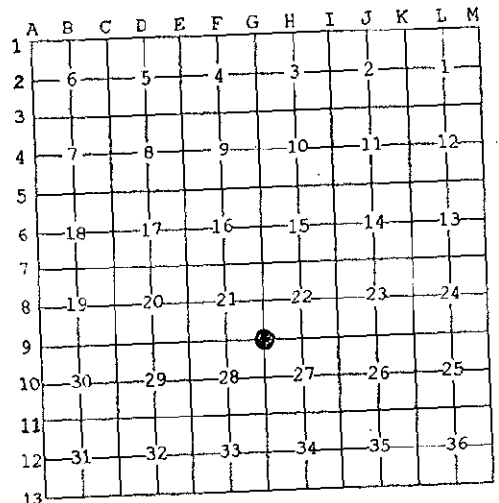

A. Description of original monument and accessories and/or subsequent restoration:

- 1852: Original Survey by Francis Coleman - B.T.'s - W. Pine, 36" - N38°W - 13 lks.; W. Pine, 12" - S55°E - 25 lks. All original evidence for this corner has been destroyed by county road improvements.
- 1982: Explanatory Sketch on the back of L.C.R.C. No. 550 by William Lenca shows this corner as being a P.K. Nail in the centerline of Co. Rd. E-W and in line with fences N-S.
- 1995: Plat of Survey by William Lenca shows an existing Railroad Spike at this corner.

B. Description of corner evidence found and/or method applied in restoring or reestablishing corner:


We recovered a Railroad Spike in the centerline of an East - West County Road and in line with ancient fences running North and South. This location fits well with existing lines of occupation and with measurements to other corners in the area, and is accepted as the best available evidence of the position of the original corner.

C. Description of monument for corner and accessories established to perpetuate locating the position of the corner:

Set 5/8" x 24" Iron Rod/3-1/4" dia. Alum. cap stamped for corner location in Monument Box:

18" dia. White Pine	N57° E	59.34 feet	Scr. NBT
7" dia. White Pine	S09° W	39.29 feet	Scr. NBT
Nail in Power Pole	S72° W	88.65 feet	
7" dia. Tamarack	N43° W	48.46 feet	Scr. NBT
Metal Survey Sign Post	South	32.60 feet	

NOTE: All bearings are magnetic bearings. All distances are measured with steel tape. Distances to trees are to nail in side of tree.

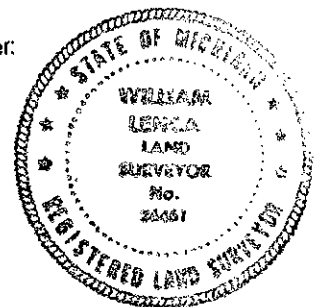

Signed by William Lenca  
Surveyor's Michigan License No. 26461

Date Nov. 23, 1999