

SURVEY & REMONUMENTATION

FEB 06 1998

Montmorency County Remonumentation Number **00012** Page **0295**

LAND CORNER RECORDATION CERTIFICATE
Filing Requirement of Act 74, Mich. P.A. 1970

For corners in **SECTION**

MONTMORENCY
 (County)

Located In:

Corner Code **≠#**

1. **ALBERT**
 Public Land Survey
2. Property Controlling
 in Section
3. Miscellaneous
 Property in Sec.
4. Lot No. _____, Recorded Plat _____
5. Private Claims _____

T29N R1E
 T____R____
 T____R____
 T____R____
 S____T____R____
 S____T____R____
 S____T____R____
 S____T____R____

I - 11

STATE OF MICHIGAN
 MONTMORENCY COUNTY
 Recorded & Filed

12-16-1997 10:53:15

A. PANGAN-MCELROY
 REGISTER OF DEEDS

Register of Deeds Stamp & File Number

| | | | | | | | | | | | | |
|----|----|----|----|----|----|----|---|---|---|---|---|---|
| A | B | C | D | E | F | G | H | I | J | K | L | M |
| 2 | 6 | 5 | 4 | 3 | 2 | 1 | | | | | | |
| 3 | | | | | | | | | | | | |
| 4 | 7 | 8 | 9 | 10 | 11 | 12 | | | | | | |
| 5 | | | | | | | | | | | | |
| 6 | 18 | 17 | 16 | 15 | 14 | 13 | | | | | | |
| 7 | | | | | | | | | | | | |
| 8 | 19 | 20 | 21 | 22 | 23 | 24 | | | | | | |
| 9 | | | | | | | | | | | | |
| 10 | 30 | 29 | 28 | 27 | 26 | 25 | | | | | | |
| 11 | | | | | | | | | | | | |
| 12 | 31 | 32 | 33 | 34 | 35 | 36 | | | | | | |
| 13 | | | | | | | | | | | | |

I, **DONALD E MARLATT**, in a field survey on 6/11, 1997, do hereby certify that under requirements of P.A. 74, Michigan P.A. of 1970, the corner points mentioned in lines 1 and 2 above were in conformance with regulations and rules therefore as required in the current manual of survey instructions of the United States Department of the Interior, Bureau of Land Management or by a decree of a Court of Law and/or that the corner points mentioned in lines 3, 4 and 5 above were in conformance with the rules of the Michigan Board of Land Surveyors or by a Decree of a Court of Law; established, re-established, monumented, re-monumented, recovered, found as expressed below:

NOTE: Not more than 4 corners, all in the same town and range, may be recorded on this certificate.

A. Description of original monument and accessories and/or subsequent restoration:

I - 11 COR. COMMON TO SEC.'S 26-27-34 & 35
 GLO COR. SET BY LEWIS CLASON-APRIL 1840. Y.pine 18"-S21°E-26 L., Y.PINE 26"-N40°W 87 L.
 F. SMITH NOTES. 4"IRON PIPE. Y.PINE 12"-S45°45'W 39.6', Y.PINE 9"-N47°45'W-71.8'.
 PLAT OF GOV'T LOT 1, SEC. 34 BY F. SMITH. NO DATE. SURVEY BY GEO. HENNING 8-2-66.
 SURVEY BY G. HENNING 10-31-66. SURVEY BY N.C.CALDWELL 3-10-73, L.1, P.316.
 SURVEY BY R.S.SCOTT ENG. CO. INC. 6-25-73. L. 1, P. 40. FD. 1/2"BAR & CAP.
 ACT 74 BY L. BEAUREGARD 3-30-81. L. 1, P. 290. FD. 1/2"BAR. N30°E 6"N.PINE 60.30'
 S55°E 8"N.PINE 46.05'; S80°W T.POLE 29.9'.
 SURVEY BY R.S.SCOTT ASSO.INC. 7-17-91. L. 4, P. 6. FD. 1/2"BAR. WITNESSES AS ABOVE.
 SURVEY BY D. MARLATT 9-7-96. S85°W P.POLE 30', S40°W 8"W.PINE 54.35', S60°W 62' 10"W.PINE.

B. Description of corner evidence found and/or method applied in restoring or reestablishing corner: WEST 33' 1"PIPE. FD. 1/2" BAR IN MON. BOX.

I -11 COR. COMMON TO SEC.'S 26-27-34 & 35
 FOUND 1/2"BAR & CAP#19237 IN MON. BOX.
 N89°W P.POLE 29.9' P.S. TAG #19237.
 S33°E 12"N.PINE 74.8' "
 N43°E 12"N.PINE 60.3' "
 S45°W 8"OAK 54.35'

OUT OF PLACE
 MONTMORENCY CO. RD. COMM.
 PLANS. DATED 6-11-91.
 FD. 1/2"BAR. (D.R. MACNEIL)
 WEST 29.99' P.POLE
 S45°E 46.38' 10"J.PINE
 N45°E 60.32' 7"J.PINE
 FORREST PARK L. 1, P.70.
 F. BATMAN 9-3-46.


C. Description of monument for corner and accessories established to perpetuate locating the position of the corner:

1 - 11 COR. COMMON TO SEC.'S 26-27-34 & 35
 PLACED REMON. CAP ON 1/2" BAR IN MON. BOX.
 N89°W P.POLE 29.90'
 S45°W 8"OAK 54.35'
 S33°E 12"N.PINE 74.8'
 N43°E 12"N.PINE 60.30'

**APPROVED BY
 PEER GROUP**

JUN 20 97

L.A.B.

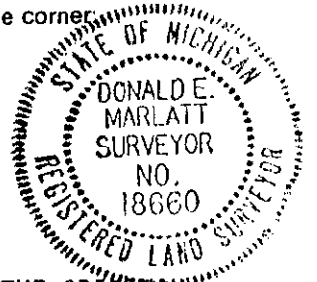

WITNESSES MARKED WITH 40 PENNY SPIKES AND P.S. TAGS # 18660,
 APPROVED BY PEER GROUP AS THE BEST AVAILABLE EVIDENCE OF THE POSITION OF THE ORIGINAL
 CORNER, on June 20, 1997.

Signed by Donald E Marlatt

Date 12/15/1997

Surveyor's Michigan License No. 18660