


NOV 23 1999

Liber 00012 Page 0359

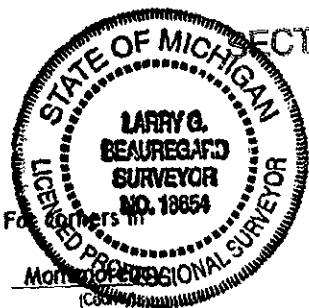

SECTION MONTMORENCY COUNTY REMONUMENTATION

LAND CORNER RECORDATION CERTIFICATE  
Filing Requirement of Act 74, Mich. P.A. 1970

STATE OF MICHIGAN  
MONTMORENCY COUNTY  
Recorded & Filed

08-10-1999 14:46:33

TERESA WALKER  
REGISTER OF DEEDS

Register of Deeds Stamp & File Number

Located in: Briley Corner Code # I-11  
(Township)

1. Public Land Survey T 30N R 2E \_\_\_\_\_  
T \_\_\_\_\_ R \_\_\_\_\_  
T \_\_\_\_\_ R \_\_\_\_\_  
T \_\_\_\_\_ R \_\_\_\_\_

2. Property Controlling S \_\_\_\_\_ T \_\_\_\_\_ R \_\_\_\_\_  
in Section S \_\_\_\_\_ T \_\_\_\_\_ R \_\_\_\_\_

3. Miscellaneous S \_\_\_\_\_ T \_\_\_\_\_ R \_\_\_\_\_  
Property In Sec. S \_\_\_\_\_ T \_\_\_\_\_ R \_\_\_\_\_

4. Lot No. \_\_\_\_\_, Recorded Plat \_\_\_\_\_

5. Private Claims \_\_\_\_\_

I, Larry G. Beauregard, in a field survey on April, 1999 do hereby certify that under requirements of P.A. 74, Michigan P.A. of 1970, the corner points mentioned in lines 1 and 2 above were in conformance with regulations and rules therefore as required in the current manual of survey instructions of the United States Department of the Interior, Bureau of Land Management or by a decree of a Court of Law and /or that the corner points mentioned in lines 3, 4 and 5 above were in conformance with the rules of the Michigan Board of Land Surveyors or by a Decree of a Court of Law; established, re-established, monumented, re-monumented, recovered, found as expressed below:

NOTE: Not more than 2 corners, all in the same town and range, may be recorded on this certificate.

A. Description of original monument and accessories and/or subsequent restoration:  
I-11 - Sec. Corner common to 26, 27, 34 & 35, T30N, R2E

1840 - Lewis Clason, D.S. Set Sec. Post. Wit's mkd.  
(B. Oak 28° N52E \* ) \* NOTE: No distance shown in GLO notes.  
(W. Oak 12° S66W 12 lks).

1973 - Delmer E. Porter, RLS #15410. Set 1/2" rod with cap by double proportionate measurement between I-9 & I-13 & G-11 & K-11. Filed LCRC, Rec. L. 1, P. 55.  
Wit's mkd. (6" Oak S80°W 10.60') (7" Oak S80°E 7.46') (6" Oak N45°W 24.37').

1977 - Kenneth J. Ostling, RLS #10068, DNR Surveyor. Fnd. Porter's 1/2" bar & Wit's in a Retracement Survey of Sec's. 27, 28, 32, 33 & 35, T30N, R2E. See map in dossier for G-10.

B. Description of corner evidence found and/or method applied in restoring or reestablishing corner:  
April, 1999 - Fnd. Porter's bar, cap & Wit's. Replaced with a 3 1/2" Aluminum Re-mon. cap on a 4" dia. X 36" conc. Mon.

C. Description of monument for corner and accessories established to perpetuate locating the position of the corner:  
I-11 - Sec. Corner Common to 26, 27, 34 & 35, T30N, R2E

3 1/2" Aluminum Re-mon. cap on 4" dia. X 36" concrete monument.

Accepted as the best available evidence of the re-establishment of the original corner.

Approved by the Peer Group on July 20, 1999.


S65°E	7.46'	(R) & (M)	7" Red Oak (R)	(Placed 60d spike & P.S. Tag #18654)
S78°E	10.60'	" " "	7" " " (R)	" " " " " "
N25°W	24.37'	" " "	8" " " (R)	" " " " " "
North	20.52'	" " "	7" W. Oak	" " " " " "

Signed by Larry G. Beauregard  
Surveyor's Michigan License No. 18654

Date, August 5, 1999

FORM APPROVED BY MICHIGAN STATE BOARD OF PROFESSIONAL SURVEYORS, JAN. 28, 19

REVISED MAY 14, 1971  
REVISED JAN., 1983  
REVISED OCT., 1995

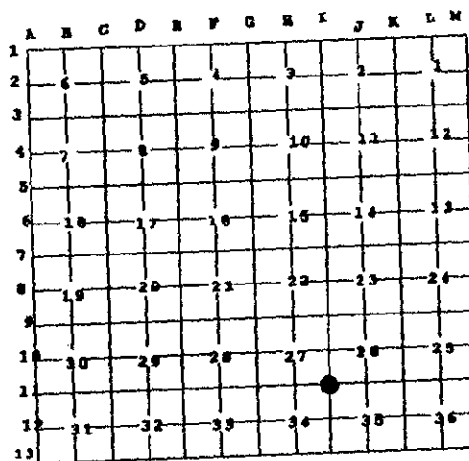

APPROVED BY  
PEER GROUP

JUL 20 99

*J.L.B.*