

**SURVEY &  
REMONUMENTATION**

**Montmorency County Remonumentation**

**APR 24 1995**

**LAND CORNER RECORDATION CERTIFICATE**

**Filing Requirement of Act 74, Mich. P.A. 1970**

For corner **COMMISSION**

Montmorency  
(County)

Located In: Montmorency Township

Corner Code ##

- 1. Public Land Survey T 32 N R 3 E A-4  
T \_\_\_\_\_ R \_\_\_\_\_  
T \_\_\_\_\_ R APPROVED BY  
T \_\_\_\_\_ R PEER GROUP
- 2. Property Controlling S \_\_\_\_\_ T \_\_\_\_\_ R \_\_\_\_\_  
in Section S \_\_\_\_\_ T \_\_\_\_\_ R \_\_\_\_\_ AUG 0 5 94
- 3. Miscellaneous S \_\_\_\_\_ T \_\_\_\_\_ R \_\_\_\_\_  
Property in Sec. S \_\_\_\_\_ T \_\_\_\_\_ R \_\_\_\_\_ *[Signature]*

STATE OF MICHIGAN  
MONTMORENCY COUNTY  
Recorded & Filed

11-10-1994 14:14:28

A. PANGAN-MCELROY  
REGISTER OF DEEDS

Register of Deeds Stamp & File Number

- 4. Lot No. \_\_\_\_\_, Recorded Plat \_\_\_\_\_
- 5. Private Claims \_\_\_\_\_

	A	B	C	D	E	F	G	H	I	J	K	L
2	6	5	4	3	2	1						
3												
4	7	8	9	10	11	12						
5												
6	18	17	16	15	14	13						
7												
8	19	20	21	22	23	24						
9												
10	30	29	28	27	26	25						
11												
12	31	32	33	34	35	36						
13												

I, Don Marlatt, in a field survey on November 8, 19 94, do hereby certify that under requirements of P.A. 74, Michigan P.A. of 1970, the corner points mentioned in lines 1 and 2 above were in conformance with regulations and rules therefore as required in the current manual of survey instructions of the United States Department of the Interior, Bureau of Land Management or by a decree of a Court of Law and/or that the corner points mentioned in lines 3, 4 and 5 above were in conformance with the rules of the Michigan Board of Land Surveyors or by a Decree of a Court of Law; established, re-established, monumented, re-monumented, recovered, found as expressed below:

**NOTE: Not more than 4 corners, all in the same town and range, may be recorded on this certificate.**

**A. Description of original monument and accessories and/or subsequent restoration:**


- (A-4) W.  $\frac{1}{4}$  Cor. Sec. 7, T 32 N, R 3 E  
Original post set by Hiram Burnham July, 1850 in South edge of marsh.  
Corner matches Call. (Beech Post).  
12" Aspen S 80° W 16 links  
12" Aspen N 62° W 28 links  
SchAAF - DNR - No Date.  
D. Porter - Recorded Act 74, L. 1, P. 397 on July 22, 1987.

**B. Description of corner evidence found and/or method applied in restoring or reestablishing corner:**

- (A-4) W.  $\frac{1}{4}$  Cor. Sec. 7, T 32 N, R 3 E  
Found 2" pipe in concrete.  
10" Maple N 34° W 22.14'  
10" Tr. Maple S 68° E 7.9'  
8" Maple S 13° W 14.27'  
8" Maple S 63° W 24.78'  
Hunting wire corner N 55° W 34'  
No evidence of original corner.  
Accepted as a perpetuation of the original government corner.

**C. Description of monument for corner and accessories established to perpetuate locating the position of the corner:**

- (A-4) W.  $\frac{1}{4}$  Cor. Sec. 7, T 32 N, R 3 E  
Left 2" pipe in concrete in place.  
Placed Remonumentation Cap.  
10" Maple N 34° W 22.18'  
8" Maple S 63° W 24.88'  
8" Maple S 13° W 14.27'  
10" Tr. Maple S 68° E 7.90'  
Witnesses marked with a 30 penny spike & I.D. tag #18660.

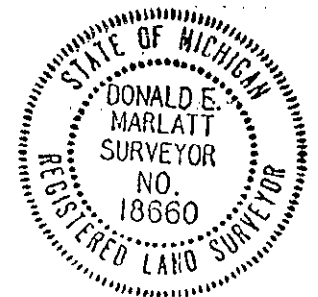

Signed by Donald E Marlatt

Date 11-9-1994

Surveyor's Michigan License No. 18660