

LIBER 19629PG347

LAND CORNER RECORDATION CERTIFICATE 71723
Filing Requirement of Act 74, Mich. P.A. 1970

For corners in

Oakland
(County)

Located in: Pontiac Corner Code #
Twp.

\$7.00 MISC RECORDING
\$2.00 REMONUMENTATION
03/03/1999 03:32:14 P.M. RECEIPT# 4986
PAID RECORDED - OAKLAND COUNTY
G. WILLIAM CABELL, CLERK/REGISTER OF DEEDS

1. Public Land Survey

T 3N R 10E L-3
T _____
T _____

2. Property Controlling in Section

S _____ T _____
S _____ T _____
S _____ T _____

3. Miscellaneous Property in Sec.

S _____ T _____
MAR 21 2000

APPROVED ON: 1-13-99 JS
OAKLAND COUNTY REMONUMENTATION
PEER GROUP COMMITTEE

Register of Deeds Stamp & File Number

4. Lot No. _____, Recorded Plat _____ SECTION _____
5. Private Claims _____

1	A	B	C	D	E	F	G	H	I	J	K	L
2		6		5		4		3		2		
3												
4		7		8		9		10		11		
5												
6		18		17		16		15		14		
7												
8		19		20		21		22		23		
9												
10		30		29		28		27		26		
11												
12		31		32		33		34		35		
13												

I, Raymond J. McCoy in a field survey on Dec. 2, 1998 do hereby state that under requirements of P.A. 74, Michigan P.A. of 1970, the corner points mentioned in lines 1 and 2 above were in conformance with regulations and rules therefore as required in the current manual of survey instructions of the United States Department of the Interior, Bureau of Land Management or by a decree of a Court of Law and/or that the corner points mentioned in lines 3, 4 and 5 above were in conformance with the rules of the Michigan Board of Land Surveyors or by a Decree of a Court of Law; established, re-established, monumented, recovered, found as expressed below:

NOTE: Not more than 2 corners, all in the same town and range, may be recorded on this certificate.

A. Description of original monument and accessories and/or subsequent restoration:

- 1817 G.L.O. Wampler D.S. Set post
- *1) 1984 P.S. #17623 L.8779, Pg.762 Found 1/2" iron at the intersection of Squirrel and Tienken Roads.
- *2) 1989 P.S. #35994 L.12236, Pg.229 Found 1" iron pipe.
- *3) 1991 P.S. #13601 L.12368, Pg.335 Found 1/2" iron pipe.
- *4) 1995 P.S. #33988 L.15237, Pg.227 Found 1" iron pipe.

B. Description of corner evidence found and/or method applied in restoring or reestablishing corner:

Found 1" iron pipe in monument box 5'± North of the centerline of Tienken Rd. and 4'± East of the centerline of Squirrel Rd. (asph. paving). Validated corner by one witness of each of the four L.C.R.C.'s recorded on this corner. This corner does not fit "Hitchman's Squirrel Road Estates" Rec. L.67, Pg.5.

State Plane Coordinate N 437077.3829
E 13431014.4743


C. Description of monument for corner and accessories established to perpetuate locating the position of the corner:
Accepted found 1" iron pipe in mon. box and replaced it with a 5/8"x24" iron rod w/2" dia. brass disk stamped Oakland County Remonumentation P.S. #21270.

Witnesses:

- N40°E 45.92' Set O.C.R.T. #21270 in NW face of 10" Elm.
- N65°E 39.78' Set O.C.R.T. #21270 in S face of L.P.
- S45°E 77.46' Set O.C.R.T. #21270 in W face of 8" Willow.
- N87°W 92.50' Set O.C.R.T. #21270 in N face of 8" Maple.

The selected location is accepted by me and is generally accepted by Professional Surveyors as the best available evidence of the position of the original corner.

Signed by Raymond J. McCoy
Surveyor's Michigan License No. 21270

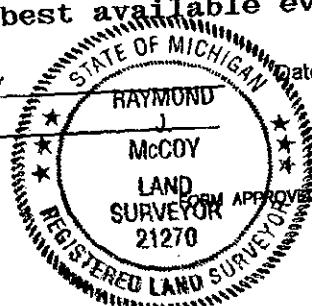

Date Jan. 21, 1999

FORM APPROVED BY MICHIGAN STATE BOARD OF PROFESSIONAL SURVEYORS, JAN 2
REVISED MAY
REVISED JAN
REVISED OC