

MAY 24 2000

LIBER 19842 PG 635

SECTION

LAND CORNER RECORDATION CERTIFICATE  
Filing Requirement of Act 74, Mich. P.A. 1970

131639

For corners in

<u>Oakland</u> (county)	Located In: <u>Rose Township</u>	Corner Code # <u>E-5</u>
1. Public Land Survey	T4N R7E	E-5
	T R	
	T R	
	T R	
2. Property Controlling S in Section S	T R	
3. Miscellaneous S Property in Sec. S	T R	

LIBER 19843 PAGE 635  
 \$9.00 MISC RECORDING  
 \$2.00 REMONUMENTATION  
 04/16/1999 08:59:10 A.M. RECEIPT# 19968  
 PAID RECORDED - OAKLAND COUNTY  
 G. WILLIAM CADDELL, CLERK/REGISTER OF DEEDS

Compliance with  
 ACT 345, P.A. 1990

APPROVED ON: 3-3-99 JS  
 OAKLAND COUNTY REMONUMENTATIO  
 PEER GROUP COMMITTEE  
 Register of Deeds Stamp & File Number

4. Lot No. \_\_\_\_\_, Recorded Plat \_\_\_\_\_

5. Private Claims \_\_\_\_\_

I, Joseph C. Kapelozak, in a field survey on March 16, 1998, do hereby certify that under requirements of P.A. 74, Michigan P.A. of 1970, the corner points mentioned in lines 1 and 2 above were in conformance with regulations and rules therefore as required in the current manual of survey instructions of the United States Department of the Interior, Bureau of Land Management or by a decree of a Court of Law and/or that the corner points mentioned in lines 3, 4 and 5 above were in conformance with the rules of the Michigan Board of Land Surveyors or by a Decree of a Court of Law; established, re-established, monumented, re-monumented, recovered, found as expressed below.

A	B	C	D	E	F	G	H	I	J	K	L	M
2	6	5	4	3	2	1						
3												
4	7	8	9	10	11	12						
5												
6	16	17	18	15	14	13						
7												
8	19	20	21	22	23	24						
9												
10	30	29	28	27	26	25						
11												
12	31	32	33	34	35	36						
13												

NOTE: Not more than 4 corners, all in the same town and range, may be recorded on this certificate.

A. Description of original monument and accessories and/or subsequent restoration:

Set post in 1816 G.L.O. Survey.  
 There are two LCRC's recorded at Oakland County; Newman 1990, and Hart 1995.

B. Description of corner evidence found and/or method applied in restoring or reestablishing corner:

Recovered a 1/2" iron in Fish Lake Road at this location. This location was validated with monumentation recovered on west R.O.W. line of Fish Lake Road south of the corner.

Recovered Witnesses:

- \*N 68°W 48.62' PK nail south side 20" Oak.
- \*S 60°W 65.26' nail north side power pole.
- \*N 40°E 23.84' PK nail northwest side quad Ash.

2P  
R


C. Description of monument for corner and accessories established to perpetuate locating the position of the corner:

Set Oakland County Remonumentation Brass Cap stamped #24598 in gravel road.

Set Witnesses:

- \*N 68°W 48.62' nail with OCRT #24598 south side 20" Oak.
- \*S 60°W 65.26' nail with OCRT #24598 north side power pole.
- \*N 40°E 23.84' nail with OCRT #24598 northwest side quad Ash.
- S 70°W 45.73' nail with OCRT #24598 northwest 12" Cherry.

\*Reused Recovered Witness

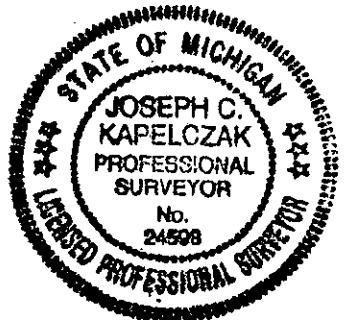

Signed by Joseph C. Kapelozak

Date 2/22/99

Surveyor's Michigan License No. 24598