

REMONUMENTATION

MAY 24 2000

DE-498347650

SECTION

LIBR 19238PC005

LAND CORNER RECORDATION CERTIFICATE
Filing Requirement of Act 74, Mich. P.A. 1970

For corners in
Oakland
(County)

Located in: Corner Code #

1. Public Land Survey	T 4N R 8E	F-9
	T R	
	T R	
	T R	
2. Property Controlling in Section	S T R	
	S T R	
3. Miscellaneous Property in Sec.	S T R	
	S T R	

4. Lot No. _____, Recorded Plat _____

5. Private Claims _____

\$ 9.00 MISCELLANEOUS RECORDING
\$ 2.00 REMONUMENTATION
4 DEC 98 8:35 A.M. RECEIPT # 48
PAID RECORDED - OAKLAND COUNTY
G. WILLIAM CADDELL
CLERK/REGISTER OF DEEDS

Compliance with
ACT 345, P.A. 1990
APPROVED ON: 04-08-98 JS
OAKLAND COUNTY REMONUMENTATION
PEER GROUP COMMITTEE
Register of Deeds Stamp & File Number

Grant J. Ward, R.L.S. February 6 98
I, _____, in a field survey on _____, 19____ do hereby state that under requirements of P.A. 74, Michigan P.A. of 1970, the corner points mentioned in lines 1 and 2 above were in conformance with regulations and rules therefore as required in the current manual of survey instructions of the United States Department of the Interior, Bureau of Land Management or by a decree of a Court of Law and/or that the corner points mentioned in lines 3, 4 and 5 above were in conformance with the rules of the Michigan Board of Land Surveyors or by a Decree of a Court of Law, established, re-established, monumented, recovered, found as expressed below:

NOTE: Not more than 2 corners, all in the same town and range, may be recorded on this certificate.


A	B	C	D	E	F	G	H	I	J	K	L	M
1												
2	6	5	4	3	2	1						
3												
4	7	8	9	10	11	12						
5												
6	18	17	16	15	14	13						
7												
8	19	20	21	22	23	24						
9												
10	30	29	28	27	26	25						
11												
12	31	32	33	34	35	36						
13												

A. Description of original monument and accessories and/or subsequent restoration:
F-9 Post, per G.L.O. Notes.

B. Description of corner evidence found and/or method applied in restoring or reestablishing corner:
F-9 North 1/4 Corner of Section 28, T. 4 N., R. 8 E. Found 1/2" Iron Rod on North Edge of Big Lake Road 13' North of Centerline, 396' West of Centerline of Jimbar Street.

Previously Recorded in L. 6961 P. 104 (2) of Oakland County Records.
(n) Indicates the number of references that confirms this corner by dimensional tie.
This corner location is accepted by the contractor and is generally accepted by professional surveyors as the best available evidence of the position of the original corner.

C. Description of monument for corner and accessories established to perpetuate locating the position of the corner.

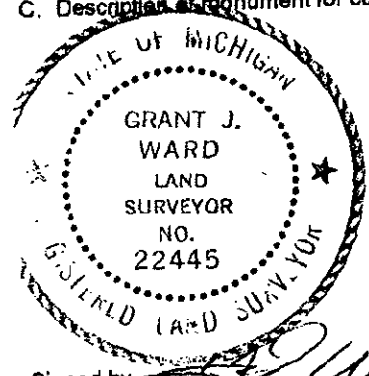

- F-9 Set Monument and Remonumentation Cap.
- N 10° E 3.86' Set MAG Nail & Remonumentation Disc in West face of 14" Oak.
- S 35° E 57.16' Set MAG Nail & Remonumentation Disc in West face of 24" Oak Cluster.
- S 20° W 33.70' Set MAG Nail & Remonumentation Disc in East face of 12" Cherry.
- N 40° W 20.60' Set MAG Nail & Remonumentation Disc in East face of 20" Cherry.

Signed by _____
Surveyor's Michigan License No. 22445

Date April 7, 1998

5.00 FILE
2.00