

LAND CORNER RECORDATION CERTIFICATE
Filing Requirement of Act 74, Mich. P.A. 1970

1905

For corners in

Oakland Located In: Corner Code #
(county)

Holly Township
 1. Public Land Survey T 5N R 7E A-10
 T R
 T R
 T R SURVEY &
 T R RE-ESTABLISHMENT
 2. Property Controlling S T R
 in Section S T R
 3. Miscellaneous S T R
 Property in Sec. S T R MAR 21 2000

LIBER 20945 PAGE 500
 \$7.00 MISC RECORDING
 \$2.00 REMONUMENTATION
 01/04/2000 07:37:46 A.M. RECEIPT# 342
 PAID RECORDED - OAKLAND COUNTY
 G. WILLIAM CARDELL, CLERK/REGISTER OF DEEDS

Compliance with
 ACT 345, P.A. 1990
 APPROVED ON: 8-4-99 JIL
 OAKLAND COUNTY REMONUMENTATION
 PEER GROUP COMMITTEE
 Register of Deeds Stamp & File Number

SECTION

4. Lot No. _____, Recorded Plat _____

5. Private Claims _____

I, James E. Kovas, in a field survey on November 30, 1999,
 do hereby certify that under requirements of P.A. 74, Michigan P.A. of 1970, the corner points
 mentioned in lines 1 and 2 above were in conformance with regulations and rules therefore as
 required in the current manual of survey instructions of the United States Department of the Interior,
 Bureau of Land Management or by a decree of a Court of Law and/or that the corner points
 mentioned in lines 3, 4 and 5 above were in conformance with the rules of the Michigan Board of
 Land Surveyors or by a Decree of a Court of Law; established, re-established, monumented,
 re-monumented, recovered, found as expressed below:

	A	B	C	D	E	F	G	H	I	J	K	L
2	6		5		4		3		2		1	
3												
4	7		8		9		10		11		12	
5												
6	13		17		16		15		14		13	
7												
8	19		20		21		22		23		24	
9												
10	30		29		28		27		26		25	
11												
12	31		32		33		34		35		36	
13												

NOTE: Not more than 4 corners, all in the same town and range, may be recorded on this certificate.


A. Description of original monument and accessories and/or subsequent restoration:
 A-10
 1816 - G.L.O., Alex Holmes, D.S., no post set
 1956 - Newberry Subdivision, Liber 88, Page 22 (no monument described)
 1973 - Oakland County Roads (witnesses sheets) found 1/4" rerod

Distances: A-10 to A-9 = 2587.30' (Wade-Trim, 1999)
 A-10 to A-11 = 2639.65' (Wade-Trim, 1999)
 A-10 to M-10 = Corner is common to both Townships (Fenton)

B. Description of corner evidence found and/or method applied in restoring or reestablishing corner:
 A-10 Found Genesee Remon - 30" Bernsten steel tube with cap.
 Found Genesee County remon tube with bras cap. This corner is common A-10 Holly with M10 Fenton
 Found old 1" pipe at Northwest corner of Subdivision 60.10' east Found 58.67'

C. Description of monument for corner and accessories established to perpetuate locating the position of the corner:
 A-10 Found Genesee County Remon disk (summer 1998). Set monument box with 5/8" rerod with remon cap.

WIT: East 50.45' Set mag nail in South face Power Pole
 N 60 E 71.89' Set mag nail in NW face 24" Oak
 West 33.62' Set mag nail in North face 12" tree
 N 40 W 54.79' Set mag nail in NE face 14" Oak

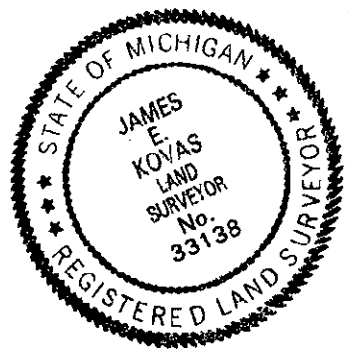

Signed by James E. Kovas Date 12/23/99