

**SURVEY &  
REMONUMENTATION**

JUN 09 1997

**LAND CORNER RECORDATION CERTIFICATE  
Filing Requirement of Act 74, Mich. P.A. 1970**

For corners in **COMMISSION**

Osceola  
(County)

Located In:

Corner Code #

- |                                       |  |            |
|---------------------------------------|--|------------|
| 1. Public Land Survey                 | T <u>1</u> E N R B W                   | H-5        |
|                                       | T <u>   </u> R <u>   </u>              | <u>   </u> |
|                                       | T <u>   </u> R <u>   </u>              | <u>   </u> |
|                                       | T <u>   </u> R <u>   </u>              | <u>   </u> |
| 2. Property Controlling<br>in Section | S <u>   </u> T <u>   </u> R <u>   </u> | <u>   </u> |
|                                       | S <u>   </u> T <u>   </u> R <u>   </u> | <u>   </u> |
| 3. Miscellaneous<br>Property in Sec.  | S <u>   </u> T <u>   </u> R <u>   </u> | <u>   </u> |
|                                       | S <u>   </u> T <u>   </u> R <u>   </u> | <u>   </u> |

APPROVED LAND CORNER  
P.A. 845 OF 1990  
Osceola County

*Matthew McClung*  
24 April 1997

Register of Deeds Stamp & File Number

4. Lot No. \_\_\_\_\_, Recorded Plat \_\_\_\_\_  
5. Private Claims \_\_\_\_\_

I, Matthew McClung, in a field survey on Apr 21, 1997 do hereby state that under requirements of P.A. 74, Michigan P.A. of 1970, the corner points mentioned in lines 1 and 2 above were in conformance with regulations and rules therefore as required in the current manual of survey instructions of the United States Department of the Interior, Bureau of Land Management or by a decree of a Court of Law and /or that the corner points mentioned in lines 3, 4 and 5 above were in conformance with the rules of the Michigan Board of Land Surveyors or by a Decree of a Court of Law; established, re-established, monumented, recovered, found as expressed below:

NOTE: Not more than 2 corners, all in the same town and range, may be recorded on this certificate.

1	A	B	C	D	E	F	G	H	I	J	K	L	M
2		6		5		4		3		2		1	
3													
4		7		8		9		10		11		12	
5								●					
6		18		17		16		15		14		13	
7													
8		19		20		21		22		23		24	
9													
10		30		29		28		27		26		25	
11													
12		31		32		33		34		35		36	
13													

A. Description of original monument and accessories and/or subsequent restoration:

The original corner was set by deputy surveyor Orson Lyon on 14 April 1847. Set wood post 40.25 chains from the East.

Hemlock 9" N261/2E 15 lks.

Hemlock 18 S59W 6 lks.

From 1891 to 1904 approximately, Osceola County had a remonumentation program, in which surveyors Temple and Trumbull, did the work. For the most part, a 3" glazed tile filled with cinders from a forge, were placed at each government set corner in the township. There were supposed to be 3 tile per corner. placed atop of each other, (continued on back)

B. Description of corner evidence found and/or method applied in restoring or reestablishing corner:

Found single tile and 3/8" Iron rod 3' long at surface could not find any other tile. Placed Osceola County Monument in tile 3" above surface, corner is in fence to West and 33' North of fence to East, 4' West of fence to North.

C. Description of monument for corner and accessories established to perpetuate locating the position of the corner:

Corner H-5. Osceola County Monument, which is a 3" brass cap mounted on a 1" pipe 18" in length.

14" Maple S38W 14.96 feet.


6" W. pine N40W 30.30 feet.

12" Maple North 14.7 feet.

10" Maple S50E 29.35 feet.

Signed by *Matthew McClung*  
Surveyor's Michigan License No. 13037

Date April 21, 1997

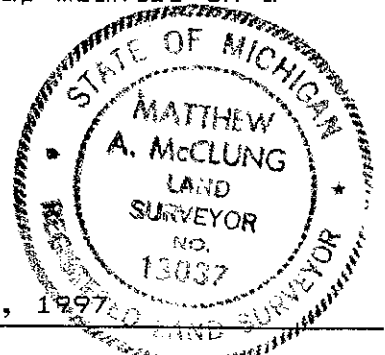

thereby making the corner 4 feet long. Sometimes a solid tile, with a cross in the top was used, and sometimes a 1/2" iron bars were added to the tile. Notes of the work were kept in ledgers, and given to the townships, and 5 of the townships have been entered in the County Surveyors records.

Distance from H-5 to G-5 = 2652.43 feet.

*Wm. B. Crawford*

97 APR 30 PM 12:33

OSCEOLA COUNTY  
REGISTER OF DEEDS

SURVEY &  
REMONUMENTATION

JUN 09 1897

COMMISSION