

SURVEY & REMONUMENTATION

APR 25 1995

COMMISSION

Ottawa County Remonumentation
LAND CORNER RECORDATION CERTIFICATE
Filing Requirement of Act 74, Mich. P.A. 1970

RECORDED

94 DEC -8 PM 12: 37

or corners in

<u>Ottawa</u> (County)	Located In:	Corner Code #
Public Land Survey	T <u>5N</u> R <u>14W</u>	<u>C-9 (SE, 19)</u>
	T _____ R _____	<u>Zeeland Twp.</u>
	T _____ R _____	_____
	T _____ R _____	_____
Property Controlling in Section	S _____ T _____ R _____	_____
Miscellaneous	S _____ T _____ R _____	_____
Property in Sec.	S _____ T _____ R _____	_____

Richard Coleman
REGISTER OF DEEDS
OTTAWA COUNTY, MI

Register of Deeds Stamp & File Number

Lot No. _____, Recorded Plat _____
Private Claims _____

John C. Bueche, in a field survey on October 25, 19 94, hereby certify that under requirements of P.A. 74, Michigan P.A. of 1970, the corner points mentioned in lines 1 and 2 above were in conformance with regulations and rules therefore as required in the current manual of survey instructions of the United States Department of the Interior, Bureau of Land Management or by a decree of a Court of Law and/or that the corner points mentioned in lines 3, 4 and 5 above were in conformance with the rules of the Michigan Board of Land Surveyors or by a Decree of a Court of Law; established, re-established, monumented, re-monumented, recovered, found as expressed below:

	A	B	C	D	E	F	G	H	I	J	K	L	M
2	6	5	4	3	2	1							
3													
4	7	8	9	10	11	12							
5													
6	18	17	16	15	14	13							
7													
8	19	20	21	22	23	24							
9													
10	30	29	28	27	26	25							
11													
12	31	32	33	34	35	36							
13													

OTE: Not more than 4 corners, all in the same town and range, may be recorded on this certificate.

Description of original monument and accessories and/or subsequent restoration:

C-9 GLO March, 1832	LCRC L3-P4
Calvin Britain, D.S.	1/2" iron in Mon. Box, Dec., 1975
Set cor.	PK in top of guard post NE 44.03'
Black Ash 18 N 40 W 18	PK in top of guard post SE 41.62'
Black Ash 18 S 30 E 5	NE bolt of NW rail
	X-way overpass S 280.5'
	C/L bit. E 9.8'

Description of corner evidence found and/or method applied in restoring or reestablishing corner:

C-9 Found 1/2" iron in Mon. Box, no cover	
	PK in top of guard post NE 44.03'
	PK in top of guard post SE 41.62'
	C/L bit. E 9.8'

And is accepted as a careful and faithful perpetuation of the position of the original corner.


PA. JAS OTTAWA COUNTY
PEER APPROVED 11/21/94

Description of monument for corner and accessories established to perpetuate locating the position of the corner:

C-9 Replaced 1/2" x 24" iron with Ottawa Co. Mon. (3/4" x 24" Pin with Cap) in Mon. Box	
PK in top of guard post	S 70 W 10.99'
PK in top of guard post	N 45 E 44.03'
PK in top of guard post	S 40 E 41.62'
Nail & Ottawa Co. Remon. Tag in top of guard post	N 15 W 46.48'
N edge of bridge over hwy.	South 290'±
C/L bit. N-S,	East 9.8'±

Signed by John C. Bueche
Surveyor's Michigan License No. 13027

Date 11-18-94

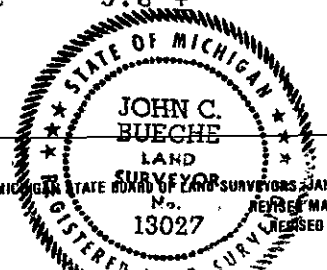

FORM APPROVED BY MICHIGAN STATE BOARD OF LAND SURVEYORS JAN. 28, 1971
REPEALED MAY 14, 1975
13027
REGISTERED JAN., 1983